


SHEET INDEX

SHEET #	SHEET DESCRIPTION
1	ELECTRICAL NOTES, LEGENDS & PROJECT SCOPE
2	ELECTRICAL EXISTING CONDITION- DEMO PLAN
3	PROPOSED ELECTRICAL SITE PLAN
4	ELECTRICAL YARD & PANEL SCHEDULE
5	REVISED ELECTRICAL RISER DIAGRAM
6	PHOTOMETRIC PERFORMANCE DATA
7-12	AS BUILT PHASE I DRAWINGS



Parks & Recreation Department
100 S. Myrtle Avenue, Clearwater, Florida 33756

COUNTRYSIDE SPORTS COMPLEX
3060 MCMULLEN BOOTH RD.
CLEARWATER, FL 33761

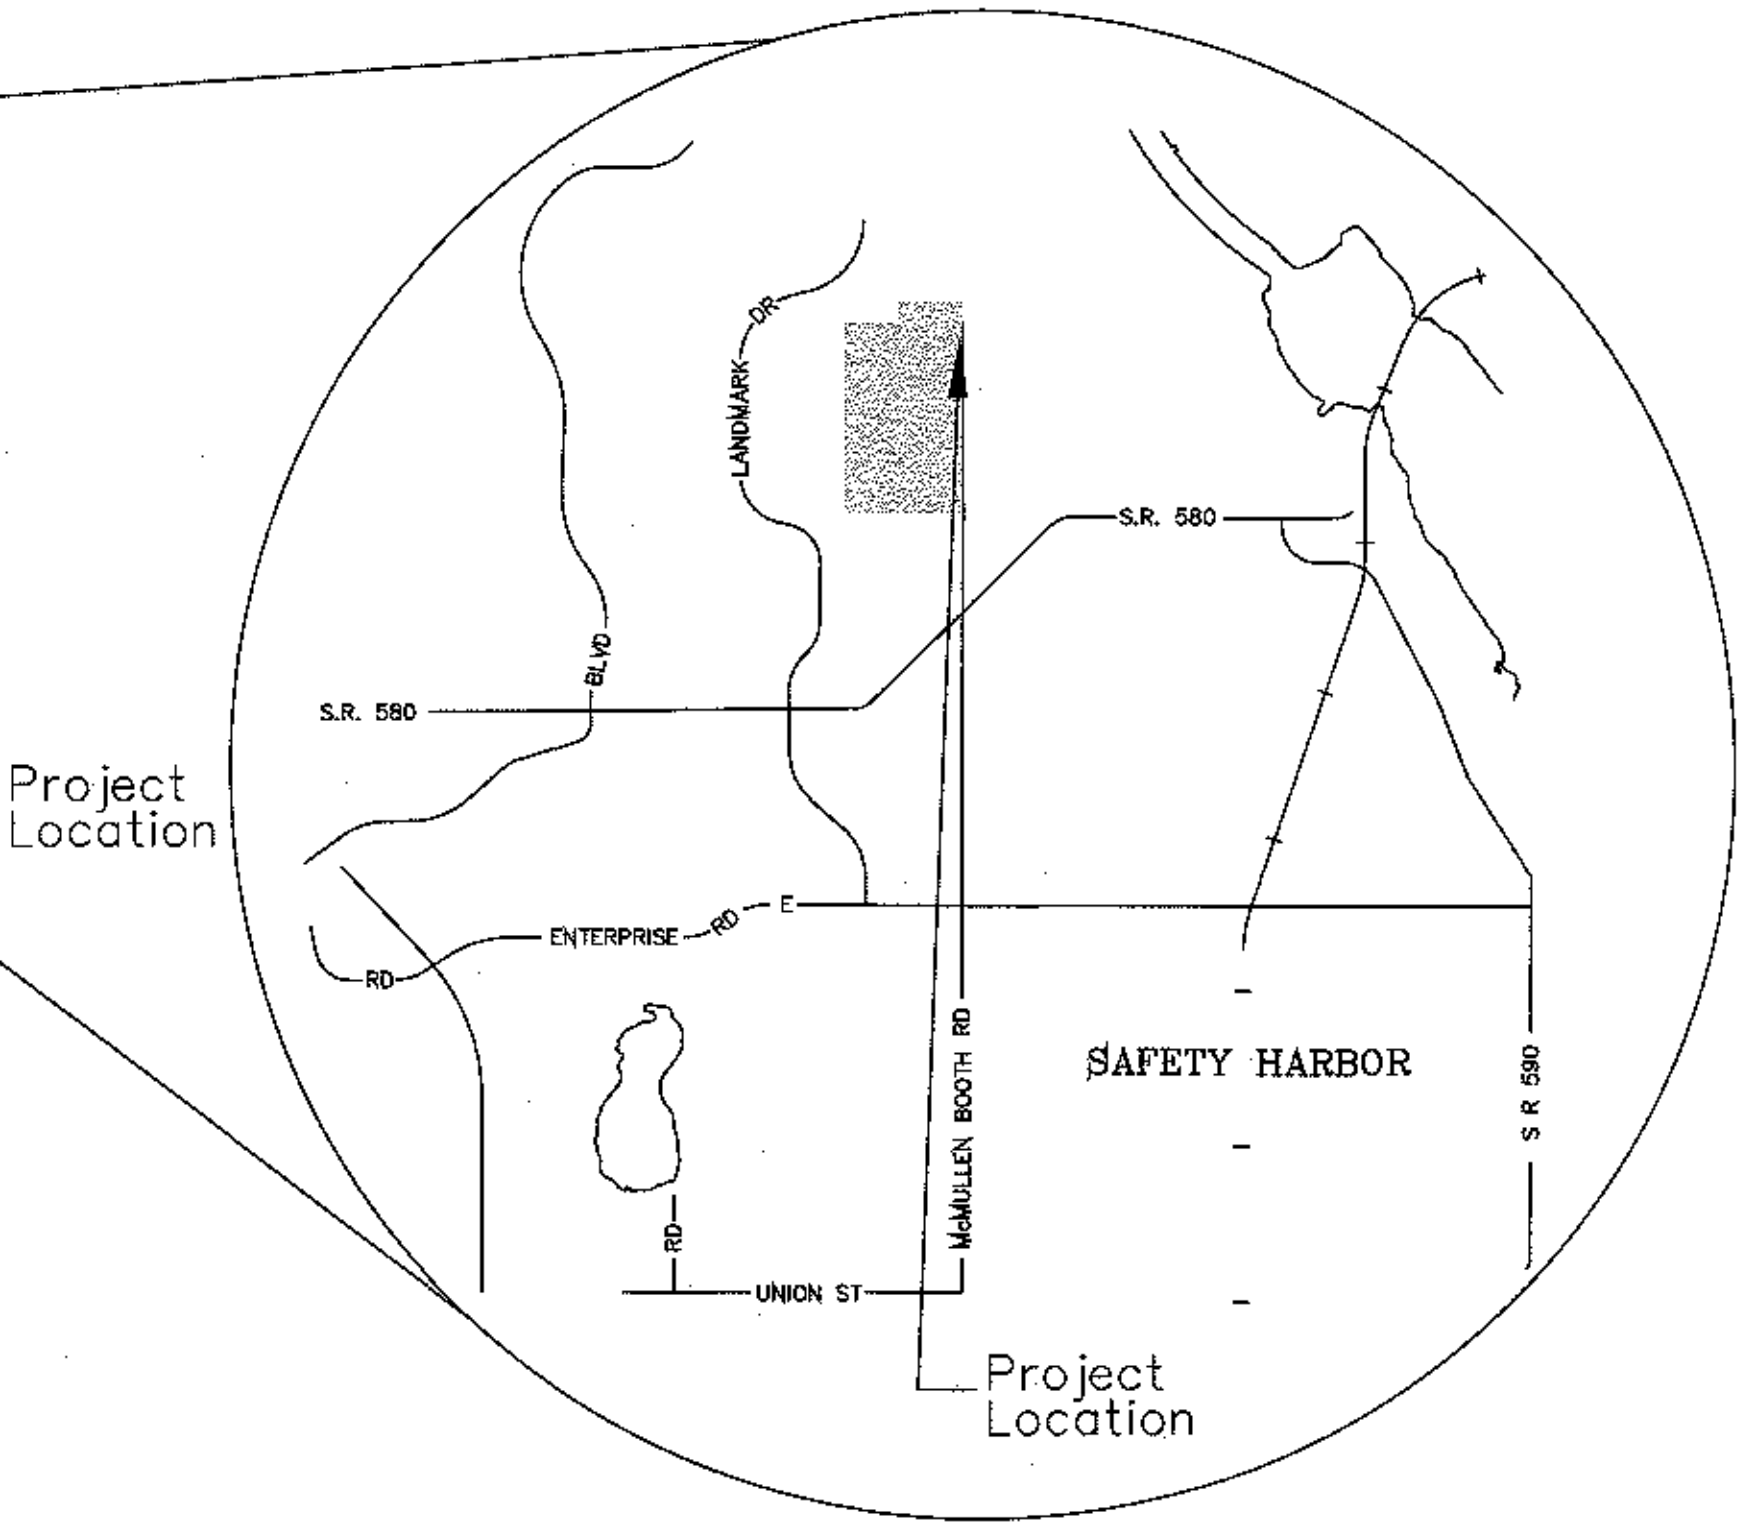

CITY OFFICIALS

Frank Hibbard	Mayor	Seat 1
Mark Bunker	Councilmember	Seat 2
Kathleen Beckman	Councilmember	Seat 3
David Allbritton	Councilmember	Seat 4
Hoyt Hamilton	Councilmember	Seat 5
William B. Horne II	City Manager	

Tara Kivett, P.E. # 86611
City Engineer

Approved For Construction *Tara Kivett*
CITY ENGINEER Tara Kivett, P.E. #86611 Confirm Date

Date 1/27/2021

RECEIVED BY: J.A.W.
JAN 28 2021
PLANNING & DEVELOPMENT
CITY OF CLEARWATER



100% SUBMITTAL

3060 MCMULLEN BOOTH RD
ELECTRICAL
COUNTRYSIDE SPORTS COMPLEX
Zoning: Open Space/Recreation Atlas # 201A

ELECTRICAL SYMBOL LEGEND

SYMBOL	DESCRIPTION	MOUNTING
	2 X 2 FLUORESCENT FIXTURE LETTER INDICATES TYPE	SEE FIXTURE SCHEDULE
	2 X 4 FLUORESCENT FIXTURE LETTER INDICATES TYPE	SEE FIXTURE SCHEDULE
	SHADING FIXTURE WITH EM BATTERY PACK. "N" DENOTES FIXTURE UN-SWITCHED FOR NIGHT LIGHT	SEE FIXTURE SCHEDULE
	2 X 4 FLUORESCENT FIXTURE (LETTER INDICATES TYPE) SHADING DENOTES FIXTURE FED FROM EMERGENCY SUPPLY	SEE FIXTURE SCHEDULE
	FLUORESCENT STRIP FIXTURE LETTER INDICATES TYPE	SEE FIXTURE SCHEDULE
	FLUORESCENT WALL BRACKET FIXTURE LETTER INDICATES TYPE	SEE FIXTURE SCHEDULE
	RECESSED DOWNLIGHT LETTER INDICATES TYPE	SEE FIXTURE SCHEDULE
	EXTERIOR DOWNLIGHT FIXTURE LETTER INDICATES TYPE	SEE FIXTURE SCHEDULE
	EXTERIOR WALL MOUNTED FIXTURE LETTER INDICATES TYPE	SEE FIXTURE SCHEDULE
	INTERIOR PENDANT FIXTURE LETTER INDICATES TYPE	SEE FIXTURE SCHEDULE
	EXTERIOR SURFACE MOUNT FIXTURE LETTER INDICATES TYPE	SEE FIXTURE SCHEDULE
	WALL LOW MOUNTED FIXTURE	SEE FIXTURE SCHEDULE
	CEILING FAN	SEE FIXTURE SCHEDULE
	EXIT-SHADING DENOTES FACEPLATE LOCATION. LETTER INDICATES TYPE. PROVIDE ARROWS AS REQUIRED.	SEE FIXTURE SCHEDULE
	DENOTES EMERGENCY WALL PACK. LETTER INDICATES TYPE.	SEE FIXTURE SCHEDULE
	DENOTES TRACK LIGHTING. LETTER INDICATES TYPE.	SEE FIXTURE SCHEDULE
	SINGLE POLE SWITCH (20A-120/277) "3" DENOTES 3-WAY, "D" DENOTES DIMMER	48" AFF OR AS NOTED
	"T" DENOTES TOGGLE SWITCH	ABOVE CEILING
	OCCUPANCY SENSOR	48" AFF OR AS NOTED
	LOW VOLTAGE LIGHTING SWITCH	48" AFF OR AS NOTED
	DUPLEX RECEPTACLE, 125V, 20A "IG" DENOTES ISOLATED GROUND	18" AFF OR AS NOTED
	DUPLEX RECEPTACLE, 125V, 20A	18" AFF OR AS NOTED
	DUPLEX RECEPTACLE, 125V, 20A	48" AFF OR AS NOTED
	QUAD RECEPTACLE, 125V, 20A	18" AFF OR AS NOTED
	SINGLE RECEPTACLE, 208V OR 240V	18" AFF OR AS NOTED
	CEILING MOUNTED COILED REEL EXTENSION RECEPTACLE.	CEILING MOUNTED
	CEILING/WALL MOUNTED BOX WITH 20A DUPLEX RECEPTACLE AND DATA OUTLET.	SEE DETAIL OR AS NOTED
	JUNCTION BOX	SEE DETAIL OR AS NOTED
	POWER/TELEPHONE POLE	SEE DETAIL OR AS NOTED
	OUTLET BOX OR J-BX FOR POWER AND DATA SUPPLY TO FURNITURE SYSTEMS	18" AFF OR AS NOTED
	FLOOR BOX WITH 20A DUPLEX RECEPTACLE AND DATA OUTLET.	SEE DETAIL OR AS NOTED
	COMBINATION VOICE/DATA OUTLET	18" AFF OR AS NOTED
	DATA OUTLET	18" AFF OR AS NOTED
	VOICE OUTLET	18" AFF OR AS NOTED
	FAX OUTLET	18" AFF OR AS NOTED
	CARD READER	COORDINATE WITH SECURITY INSTALLER
	SURVEILLANCE CAMERA	COORDINATE WITH SECURITY INSTALLER
	T.V. OUTLET	18" AFF OR AS NOTED
	PANELBOARD 120/208V	SEE PANEL SCHEDULE
	PANELBOARD 277/480V	SEE PANEL SCHEDULE
	RACEWAY CONCEALED IN WALL OR ABOVE CEILING	SEE SPECIFICATIONS
	UNDERGROUND OR UNDER FLOOR CONDUIT	SEE SPECIFICATIONS
	HOME RUN TO PANEL LETTERS INDICATE PANEL NUMBERS INDICATE CIRCUIT. NOTE: HASH MARKS INDICATES THE NUMBER OF WIRES EXCLUDING THE REQUIRED EQUIPMENT GROUND.	SEE SPECIFICATIONS
	MOTOR, NUMERAL INDICATES HORSEPOWER	AS NOTED
	MOTOR RATED SWITCH WITH OVERLOAD RELAYS AS REQUIRED.	MOUNTED ADJACENT TO EQUIPMENT
	NON-FUSIBLE SAFETY SWITCH-SIZE AS NOTED	SEE SPECIFICATIONS
	FUSIBLE SAFETY SWITCH-SIZE AS NOTED	SEE SPECIFICATIONS

*NOTE - ALL SYMBOLS SHOWN MAY NOT BE USED.

ABBREVIATIONS:

AFF - ABOVE FINISHED FLOOR	HVAC - HEATING, VENTILATING, AIR CONDITIONING
AHU - AIR HANDLING UNIT	JB - JUNCTION BOX
BFC - BELOW FINISHED GRADE	LBA - LOCKED ROTOR AMPERES
C - CONDUIT	MCB - MAIN CIRCUIT BREAKER
OW - COOL WHITE	MLO - MAIN LUGS ONLY
DACP - DOOR ALARM CONTROL PANEL	N - NEUTRAL
DN - FEED DOWNWARD	NL - NIGHT LIGHT
EF - EXHAUST FAN	OB - OUTLET BOX
ENCL - EQUIPMENT GROUND	PB - PULL BOX, PUSH-BUTTON
ENCL - ENCLOSURE	PS - PAY STATION
EWC - ELECTRIC WATER COOLER	SPC - SPECIFICATIONS
EW - ELECTRIC WATER HEATER	TL - TWISTLOCK
WK - EXPLOSION PROOF	TB - TELEPHONE TERMINAL BOARD
FCU - FAN COIL UNIT	TYB - TELEVISION TERMINAL BOARD
FHP - FRACTIONAL HORSEPOWER	UNO - UNLESS NOTED OTHERWISE
FL - FULL LOAD AMPERES	UP - FEED UPWARD
G - GROUND	VERT - VERTICAL
GFI - GROUND FAULT INTERRUPTER	WM - WATT METER
HID - HIGH INTENSITY DISCHARGE	WP - WEATHERPROOF
HORIZ - HORIZONTAL	WW - WARM WHITE
IG - ISOLATED GROUND	XFM - TRANSFORMER
LW - LIGHT WHITE	NLC - NOT IN CONTRACT
HP - HORSEPOWER, HEAT PUMP	

NOTE:
1. ALL MOUNTING HEIGHTS SHOWN ARE TO THE TOP OF THE DEVICE UNLESS NOTED OTHERWISE.
2. NOT ALL SYMBOLS APPEAR ON PLANS.

ELECTRICAL GENERAL NOTES:

- ALL WORK SHALL CONFORM TO THE REQUIREMENTS OF THE FLORIDA BUILDING CODE 2020 (7TH EDITION) - NATIONAL ELECTRIC CODE 2017, NFPA 70 - NFPA 101 & NFPA 72 (CURRENT ADOPTED EDITIONS). ANY OTHER APPLICABLE CODE REFERENCES AND ALL LOCAL ORDINANCES.
- BIDDERS ARE TO VISIT THE SITE AND FAMILIARIZE THEMSELVES WITH EXISTING CONDITIONS AND SATISFY THEMSELVES AS TO THE NATURE AND SCOPE OF WORK AND THE EXTENT OF DEMOLITION. THE SUBMISSION OF A BID WILL BE EVIDENCED THAT SUCH AN EXAMINATION HAS BEEN MADE. LATER CLAIMS FOR LABOR, EQUIPMENT OR MATERIALS REQUIRED, OR FOR DIFFICULTIES ENCOUNTERED WHICH COULD HAVE BEEN FORESEEN HAD AN EXAMINATION BEEN MADE, WILL NOT BE ALLOWED.
- ELECTRICAL CONTRACTOR SHALL BE EXPERIENCED IN PERFORMING AND INSTALLATION OF WORK SIMILAR TO THAT REQUIRED FOR THIS PROJECT. THE CONTRACTOR SHALL SUBMIT A LIST OF AT LEAST FIVE PROJECTS THAT THEY BEEN CONTRACTED AND COMPLETED CONSTRUCTION WITH SIMILAR PROJECT SCOPE OF WORK.
- PRIOR TO SUBMITTING A BID, THE CONTRACTOR SHALL HAVE STUDIED AND COMPARED THE CONTRACT DOCUMENTS WITH EXISTING/PROPOSED CONDITIONS AND NOT LATER THAN TEN (10) DAYS PRIOR TO THE BID OPENING SHALL REPORT TO THE ENGINEER ANY ERROR, INCONSISTENCY, OR OMISSION IN THE CONTRACT DOCUMENTS.
- ELECTRICAL EQUIPMENT SHALL BE AS SPECIFIED. ARCHITECT AND ENGINEER WILL REVIEW ANY SUBSTITUTION FOR COMPATIBILITY.
- ALL CUTTING, REMOVING AND REPLACING CONCRETE WORK SHALL BE THE RESPONSIBILITY OF THIS TRADE.
- PROTECT ELECTRICAL EQUIPMENT AND INSTALLATIONS AS NECESSARY. IF DAMAGED OR DISTURBED IN THE COURSE OF THE WORK, REMOVE DAMAGED PORTIONS AND INSTALL NEW PRODUCTS OF EQUAL CAPACITY, QUALITY, AND FUNCTIONALITY.
- THE CONTRACTOR SHALL INCLUDE WITHIN THE BID ALL REQUIRED OFF HOUR, OVERTIME, AND NON-BUSINESS HOUR WORK AS REQUIRED.
- ALL WORK SHALL BE COORDINATED WITH OTHER TRADES FOR ITEMS IN THEIR SCOPE OF WORK WHICH WOULD REQUIRE ELECTRICAL WORK (DISCONNECTION/RECONNECTION ETC.) AND ARE NOT INDICATED ON THE ELECTRICAL PLANS. ALL SUBCONTRACTORS ARE REQUIRED TO COORDINATE THEIR WORK WITH OTHER TRADES. LACK OF THIS COORDINATION RESULTING IN ADDED COST TO THE CONTRACT WILL BE BORNE BY THE CONTRACTOR OF THIS PROJECT.
- THE CONTRACTOR SHALL PROVIDE SHOP DRAWINGS AND SUBMITTALS FOR ELECTRICAL EQUIPMENT SHOWN ON THE PLANS AND SPECIFICATIONS FOR THE ENGINEERS APPROVAL. THE ENGINEER MAY REQUIRE THE CONTRACTOR TO REDO ANY WORK WHICH WAS NOT APPROVED, OR THE ENGINEER MAY REQUIRE A CREDIT TO THE OWNER. PROVIDE A SET OF AS-BUILT AFTER THE JOB IS COMPLETED. THIS SET SHALL BE CONTINUOUSLY UPDATED DURING CONSTRUCTION.
- PROVIDE IDENTIFICATION FOR ALL LIGHT FIXTURES AND ALL ELECTRICAL COVER PLATES WITH PERMANENT MARKER ON A SELF-ADHERING TAG INDICATING PANEL AND CIRCUIT NUMBER. TYPICAL FOR ALL LIGHTING AND POWER DEVICES.
- ALL WORK SHALL BE PERFORMED DURING TIME PERIODS ACCEPTABLE TO THE OWNER. SCHEDULE ALL WORK WITH THE OWNER'S REPRESENTATIVE BEFORE PROCEEDING.
- THE CONTRACTOR SHALL PERFORM ALL TEMPORARY WORK NECESSARY TO MAINTAIN CONTINUITY OF ELECTRICAL SERVICE (LIKE SAMPLE SERVICE) WHEN CONNECTION IS MADE. THIS SERVICE SHALL NOT BE INTERRUPTED WITHOUT PRIOR CONSENT OF THE OWNER'S REPRESENTATIVE AND MAY BE INTERRUPTED ONLY AT AND FOR THE SPECIFIED TIME DESIGNATED BY OWNER'S REPRESENTATIVE. THE CONTRACTOR SHALL BE GUIDED BY THE OWNER'S REPRESENTATIVE AT ALL TIMES IN MATTERS AFFECTING THE FACILITIES.
- THE CONTRACTOR SHALL COORDINATE ALL PHASING OF ELECTRICAL WORK AS REQUIRED AND INDICATED ON THE ELECTRICAL DRAWINGS.
- THE OWNER PROJECT REPRESENTATIVE SHALL BE NOTIFIED PRIOR TO CUTTING OF ANY STRUCTURAL ITEM (I.E. CONCRETE FLOOR, MASONRY, WALL, ETC.) WITHIN THE EXISTING BUILDING. METHOD OF CUTTING SHALL BE APPROVED BY THE OWNER PROJECT REPRESENTATIVE.
- CONTRACTOR SHALL BE RESPONSIBLE FOR KEEPING THE BUILDING WATERTIGHT DURING CONSTRUCTION.
- ALL WIRING IN CEILING SPACE OR IN AIR HANDLING PLENUMS NOT IN CONDUIT SHALL BE UL LISTED AS SUITABLE FOR PLENUM USE.
- ALL JUNCTION BOXES AND COVER PLATES SHALL BE PAINTED AND LABELED.
- ALL RECEPTACLES WITHIN (6) FEET OF PLUMBING FIXTURES SHALL BE PROVIDED WITH 5 MILLIAMP GROUND FAULT INTERRUPTERS. (GFCI RECEPTACLES)
- EXIT SIGNS AND ALL EMERGENCY LIGHTING SHALL BE WIRED AHEAD OF ANY SWITCHING OR CONTACTORS. DO NOT SWITCH EXIT SIGNS OR EMERGENCY NIGHT LIGHTS. CONTRACTOR SHALL PROVIDE AN UNSWITCHED HOT TO BYPASS ANY SWITCHING AND/OR CONTRACTORS FOR ALL SWITCHED EMERGENCY LIGHTING.
- EDGE OF LIGHT SWITCH WALL PLATE SHALL BE NOT MORE THAN 4" AWAY FROM METAL/WOOD DOOR FRAME. TYPICAL FOR SINGLE OR MULTIPLE WALL SWITCHES.
- CONFIRM MOUNTING HEIGHTS AND COORDINATE LOCATION OF ALL OUTLETS, SWITCHES, AND OTHER DEVICES WITH ARCHITECTURAL ELEVATIONS (FURNITURE LAYOUT) PRIOR TO ROUGH-IN.
- PROVIDE SEAL FOR PENETRATION OF FIRE RATED WALLS BY CONDUIT.
- BACK TO BACK RECEPTACLES IN ALL ONE HOUR FIRE RATED WALLS SHALL BE LOCATED A MINIMUM OF 24" ON CENTER.
- BRANCH CIRCUIT CONDUCTORS SHALL NOT BE SMALLER THAN NO. 12 AND WHERE BRANCH CIRCUIT CONDUCTOR RUNS FROM SOURCE (PANEL) TO THE LAST DEVICE ON THE CIRCUIT EXCEEDS 75 FT. IN LENGTH, THE CONDUCTORS SHALL BE NO. 10 MINIMUM AND FOR THE ENTIRE LENGTH OF THE CIRCUIT. FOR RUNS OVER 150 FT. IN LENGTH THE CONDUCTOR SHALL BE NO. 8 MINIMUM AND FOR THE ENTIRE LENGTH OF THE CIRCUIT. THE ABOVE APPLIES TO 120 VOLT CIRCUITS ONLY.
- THE CONTRACTOR SHALL COORDINATE WITH THE OWNER THE REMOVAL AND DISPOSAL OF ALL ELECTRICAL MATERIAL WHICH IS NOT TO BE USED ON THE PROJECT. CONTRACTOR SHALL REMOVE AND STORE ANY ELECTRICAL MATERIAL IF SO DIRECTED BY OWNER. PATCH AND PAINT WALLS AND CEILINGS AS REQUIRED. THE CONTRACTOR SHALL COORDINATE INSTALLATION OF NEW LIGHTING FIXTURES, RECEPTACLES, PANEL BOARDS, ETC. WITH EXISTING STRUCTURE, PIPING, ETC. AND MAKE ADJUSTMENTS AS REQUIRED.
- REFER TO ELECTRICAL SPECIFICATIONS SHEET FOR REQUIREMENTS.
- UPON COMPLETION OF THE WORK, THE CONTRACTOR SHALL INSURE THAT ALL SYSTEMS OPERATE AS DESIGNED AND REQUIRED AND SHALL REVIEW THEIR OPERATION WITH THE OWNER AND PROVIDE TRAINING OF THE MAINTENANCE PERSONNEL. COMPLETE 5 SETS OF AS-BUILT DRAWINGS SHALL BE COMPILED (BY THE CONTRACTOR) AND ISSUED (1 EACH) TO THE ARCHITECT AND BUILDING MAINTENANCE PERSONNEL UPON COMPLETION OF CONSTRUCTION AND TESTING. PROVIDE 3 FLASH DRIVE OF AS-BUILT TO THE OWNER.
- ALL FEEDERS SIZING (BRANCH AND SERVICE ENTRANCE CONDUCTORS) BASED IN AMPACITY OF COPPER THHN CONDUCTORS (NEC 2017 TABLE 310.15(B)(16)) UNLESS OTHERWISE NOTED.
- THE PRIMARY POWER SOURCE FOR SMOKE ALARMS IN DWELLING UNITS SHALL BE REQUIRED TO BE AFCI-PROTECTED FOLLOWING NFPA 72 AND NEC 2017 ART. 210.12.
- RECEPTACLES LOCATED IN DORMITORIES AND LIVING AREAS OF ALL DWELLING UNITS SHALL BE AFCI PROTECTED.
- MINIMUM SERVICE INTERRUPTION OF EXISTING FIELD SHALL BE KEPT TO A MINIMUM. EXISTING TRANSFORMER SHALL REMAIN OPERATIONAL UNTIL NEW TRANSFORMER IS IN PLACE AND SWITCHOVER SHALL OCCUR WITHIN 24 HRS BETWEEN SHUT DOWN & START UP OF NEW POLE & SERVICES.

NATIONAL ELECTRIC CODE NOTES:

ALL WORK SHALL CONFORM TO THE REQUIREMENTS OF NFPA 70 - 2017 NATIONAL ELECTRIC CODE

ELECTRICAL SUBMITTAL NOTES:

SUBMIT ALL ELECTRICAL SYSTEMS SUBMITTALS AT ONE (1) TIME IN ONE (1) INTEGRAL GROUP. PIECE-BY-PIECE SUBMISSION OF INDIVIDUAL ITEMS WILL NOT BE ACCEPTABLE. ENGINEER MAY CHECK CONTENTS OF EACH SUBMITTAL SET UPON INITIAL DELIVERY. IF NOT COMPLETE AS SET FORTH HEREIN, SUBMITTAL SETS MAY BE RETURNED TO CONTRACTOR WITHOUT REVIEW AND APPROVAL AND WILL NOT BE ACCEPTED UNTIL MADE COMPLETE. SHOP DRAWINGS WILL BE REVIEWED MAXIMUM TWICE AS PART OF THIS CONTRACT. ADDITIONAL SHOP DRAWING REVIEWS SHALL BE INVOICED AT \$85.00 PER HOUR. BILLABLE TO THE SUB-CONTRACTOR.

LIGHTING DESIGN SUMMARY

Countryside Field 2 Redesign
November 10, 2020

DESIGN OBJECTIVE: Increase soccer field size from 330' x 200' (66,000 sq. ft) to 360 x 225 (81,000 sq. ft). Light to 30fc Minimum

CONDITIONS: Existing poles (S5 & S6) were installed and designed in 2011 Poles were designed using FBC 2007, 130mph, AASHTO standards They each have 7 fixtures each Poles are to be moved east. The existing FBC (2017) uses 150mph, ASCE standards Using current FBC, S5 & S6 will only handle 4 fixtures each.

SCOPE OF WORK S5 & S6 will be removed. They currently have 7 fixtures each New bases will be supplied and these existing poles will be re-installed with 4 fixtures per pole

The remaining (3) fixtures per pole are to be moved and re-used on new pole P8.

An additional 6 fixtures will be supplied to be attached to pole P8 for a total of 12 total fixtures on this pole

Pole P4 will be added with 13 fixtures.

Pole P3 (existing) will have 14 fixtures added

EQUIPMENT

1 x 70' mh Steel pole & base (P8)
1 x 80' mh Steel pole & base (P4)
2 new bases for relocation of existing 2 poles (S5 & S6)
33 New fixtures
Re-use 6 existing fixtures (moved to P8)

NOTE:

- THE ELECTRICAL CONTRACTOR SHALL PROVIDE ALL OTHER ELECTRICAL ITEMS TO PROVIDE A COMPLETE OPERATIONAL SPORT LIGHTING SYSTEM TO THE SATISFACTION OF THE OWNER WITH A 30 FOOT CANDLE MINIMUM AFTER BURN IN OF THE LAMPS.

DRAWING INDEX

SHEET NUMBER	DRAWING TITLE
E0	ELECTRICAL NOTES, LEGEND & PROJECT SCOPE
E1	ELECTRICAL EXISTING CONDITION - DEMO PLAN
E2	PROPOSED ELECTRICAL SITE PLAN
E3	ELECTRICAL YARD AND PANEL SCHEDULES
E4	REVISED ELECTRICAL RISER DIAGRAM
E5	PHOTOMETRIC PERFORMANCE DATA


NOTE:

- AS BUILT PHASE I DRAWINGS HAS ALSO BEEN INCLUDED IN THIS PACKAGE

DRAWING INDEX AS BUILT PHASE I

SHEET NUMBER	DRAWING TITLE
E0	ELECTRICAL COVER SHEET
E1	ELECTRICAL EXISTING CONDITION - DEMO PLAN
E2	ELECTRICAL SITE PLAN
E3	ELECTRICAL YARD AND SCHEDULES
E4	REVISED ELECTRICAL RISER DIAGRAM
E5	PHOTOMETRIC PERFORMANCE DATA

Musco Sports Lighting * 2220 Cluster Oak Dr. #H1 * Clermont, FL 34711
Telephone (352) 243-9999 * Fax (352) 243-2791

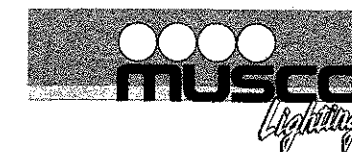**Budget Estimate**

COUNTRYSIDE SOCCER REDESIGN
Field 2
Date: November 17, 2020

Field Description: **Based on Musco lighting design 1890388**

Light Structure Green™ System delivered to your site in Five Easy Pieces™

- 4 x Pre-cast concrete bases
- 1 x galvanized 70' mh steel poles (P8)
- 1 x galvanized 80' mh steel poles (P4)
- UL Listed remote electrical component enclosure & Pole length wire harness
- 33 x Factory-aimed and assembled luminaires

Also includes:

- Energy savings of more than 50% over a standard lighting system
- 50% less spill and glare light than Musco's prior industry leading technology
- Musco C10 Warranty and maintenance

Materials (Poles & Fixtures)

Musco's Light Structure Cluster Green™ as described above and delivered to the job site \$132,200.00

- Sales tax is not included as part of this budget estimate.
- Materials Only

Scope

Pole P8 will be added.
Pole P4 will be added
Existing poles S5 & S6 will be moved
New bases for these poles will be supplied
Three fixtures from each existing poles S5 & S6 will be added to new poles P8
Remaining fixtures for poles S5 & S6 will be re-aimed while on the ground
Fixtures to be attached to existing pole P3 will be added

Pricing furnished is considered confidential. Divulging technical or pricing information to competitive vendors will result in removal from the bid list.

Robert A. DeCouto

PROJECT COORDINATION NOTES:

- ALL BURIED ELECTRICAL WIRES SHALL HAVE WATER PROOF CONNECTORS & 2 EXTRA FEET OF CONDUCTORS COILED IN AN ELECTRICAL GROUND BOX. INSIDE ELECTRICAL GROUND BOXES, CONDUIT BOXES ELECTRICAL ELBOWS SHALL BE PROVIDED AT END OF ELECTRICAL CONDUITS. MATERIAL SUBMITTAL SHALL BE PROVIDED TO OWNER/ELECTRICAL CONSULTANT FOR REVIEW.
- ALL BURIED CONDUITS/SLEEVES AND ELECTRICAL BOXES SHALL HAVE 'AS BUILT' DRAWINGS DEVELOPED IDENTIFYING LOCATION FOR FUTURE LOCATIONS- AS BUILT DRAWINGS SHALL BE REVIEWED IN THE FIELD WITH OWNER/ELECTRICAL CONTRACTOR/ELECTRICAL CONSULTANT TO DETERMINE ACCURACY OF 'AS BUILT' DRAWINGS BEFORE FINAL HANDOVER OF PROJECT TO OWNER
- 6 FEET HIGH TEMPORARY CONSTRUCTION FENCE SHALL BE PLACED ON STANDS AT 20 FEET WEST OF EXISTING LIGHT POLES THAT ARE TO BE REMOVED. SEE SHEET # 2 (DEMO PLAN) FOR REFERENCE ON THE LOCATION OF THE 6 FEET TEMPORARY FENCE. FENCE PANELS SHALL BE PROVIDED BY THE OWNER FOR CONTRACTOR TO INSTALL AT BEGINNING OF PROJECT AND REMOVE AT THE END OF PROJECT. CONTRACTOR SHALL REMOVE AND RESTACK ON OWNER'S PROVIDED TRAILER.
- ALL OTHER ELECTRICAL ITEMS NOT PROVIDED BY MUSCO SHALL BE PROVIDED BY THE CONTRACTOR IN PROVIDING A COMPLETE OPERABLE SPORT LIGHTING SYSTEM TO THE SATISFACTION OF THE OWNER.

RECEIVED BY: J.A.W.
JAN 28 2021
PLANNING & DEVELOPMENT
CITY OF CLEARWATER

CALL 811
SUNSHINE STATE
ONE CALL
OF FLORIDA
www.callsunshine.com
(800) 432-4770
MAX 48 HOURS
BEFORE YOU EXCAVATE

DRAWN BY SK/JAR	DESIGNED BY	CHECKED BY JAR	CLEARWATER CONTRACT NO.
SCALE VERT. NONE	SURVEYED BY Clearwater	BOOK NO.	CLEARWATER JOB NO.
HORIZ. 1"=N/A	DATE DRAWN Dec 04, 2020	DWG NAME 2020-XXXX	SHEET NO. 1
JOSE A ROSARIO, P.E. 74457			DATE


RECORD DRAWINGS	
SURVEYED BY	DRAWN BY
REVIEWED BY	PROJECT ENGINEER
DATE	DATE
APPROVED BY	CITY ENGINEER MICHAEL D. QUINN, P.E. # 33721
DATE	DATE




CITY OF CLEARWATER, FLORIDA
PARKS & RECREATION DEPT.
100 S. Myrtle Ave.
Clearwater, FL 33756

REVISION BY DATE

GRINER
GRINER ENGINEERING, INC.
1628 First Avenue North
St. Petersburg, Florida 33713
Phone: (727)-822-2335
Fax: (727)-821-3361
Certificate of Authorization #3173

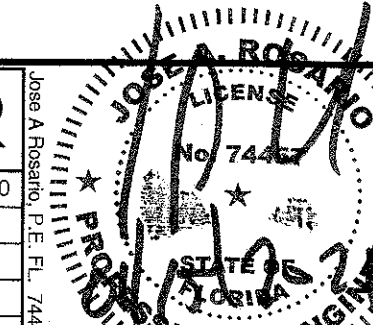


COUNTRYSIDE SPORTS COMPLEX
FIELD 2 RENOVATION

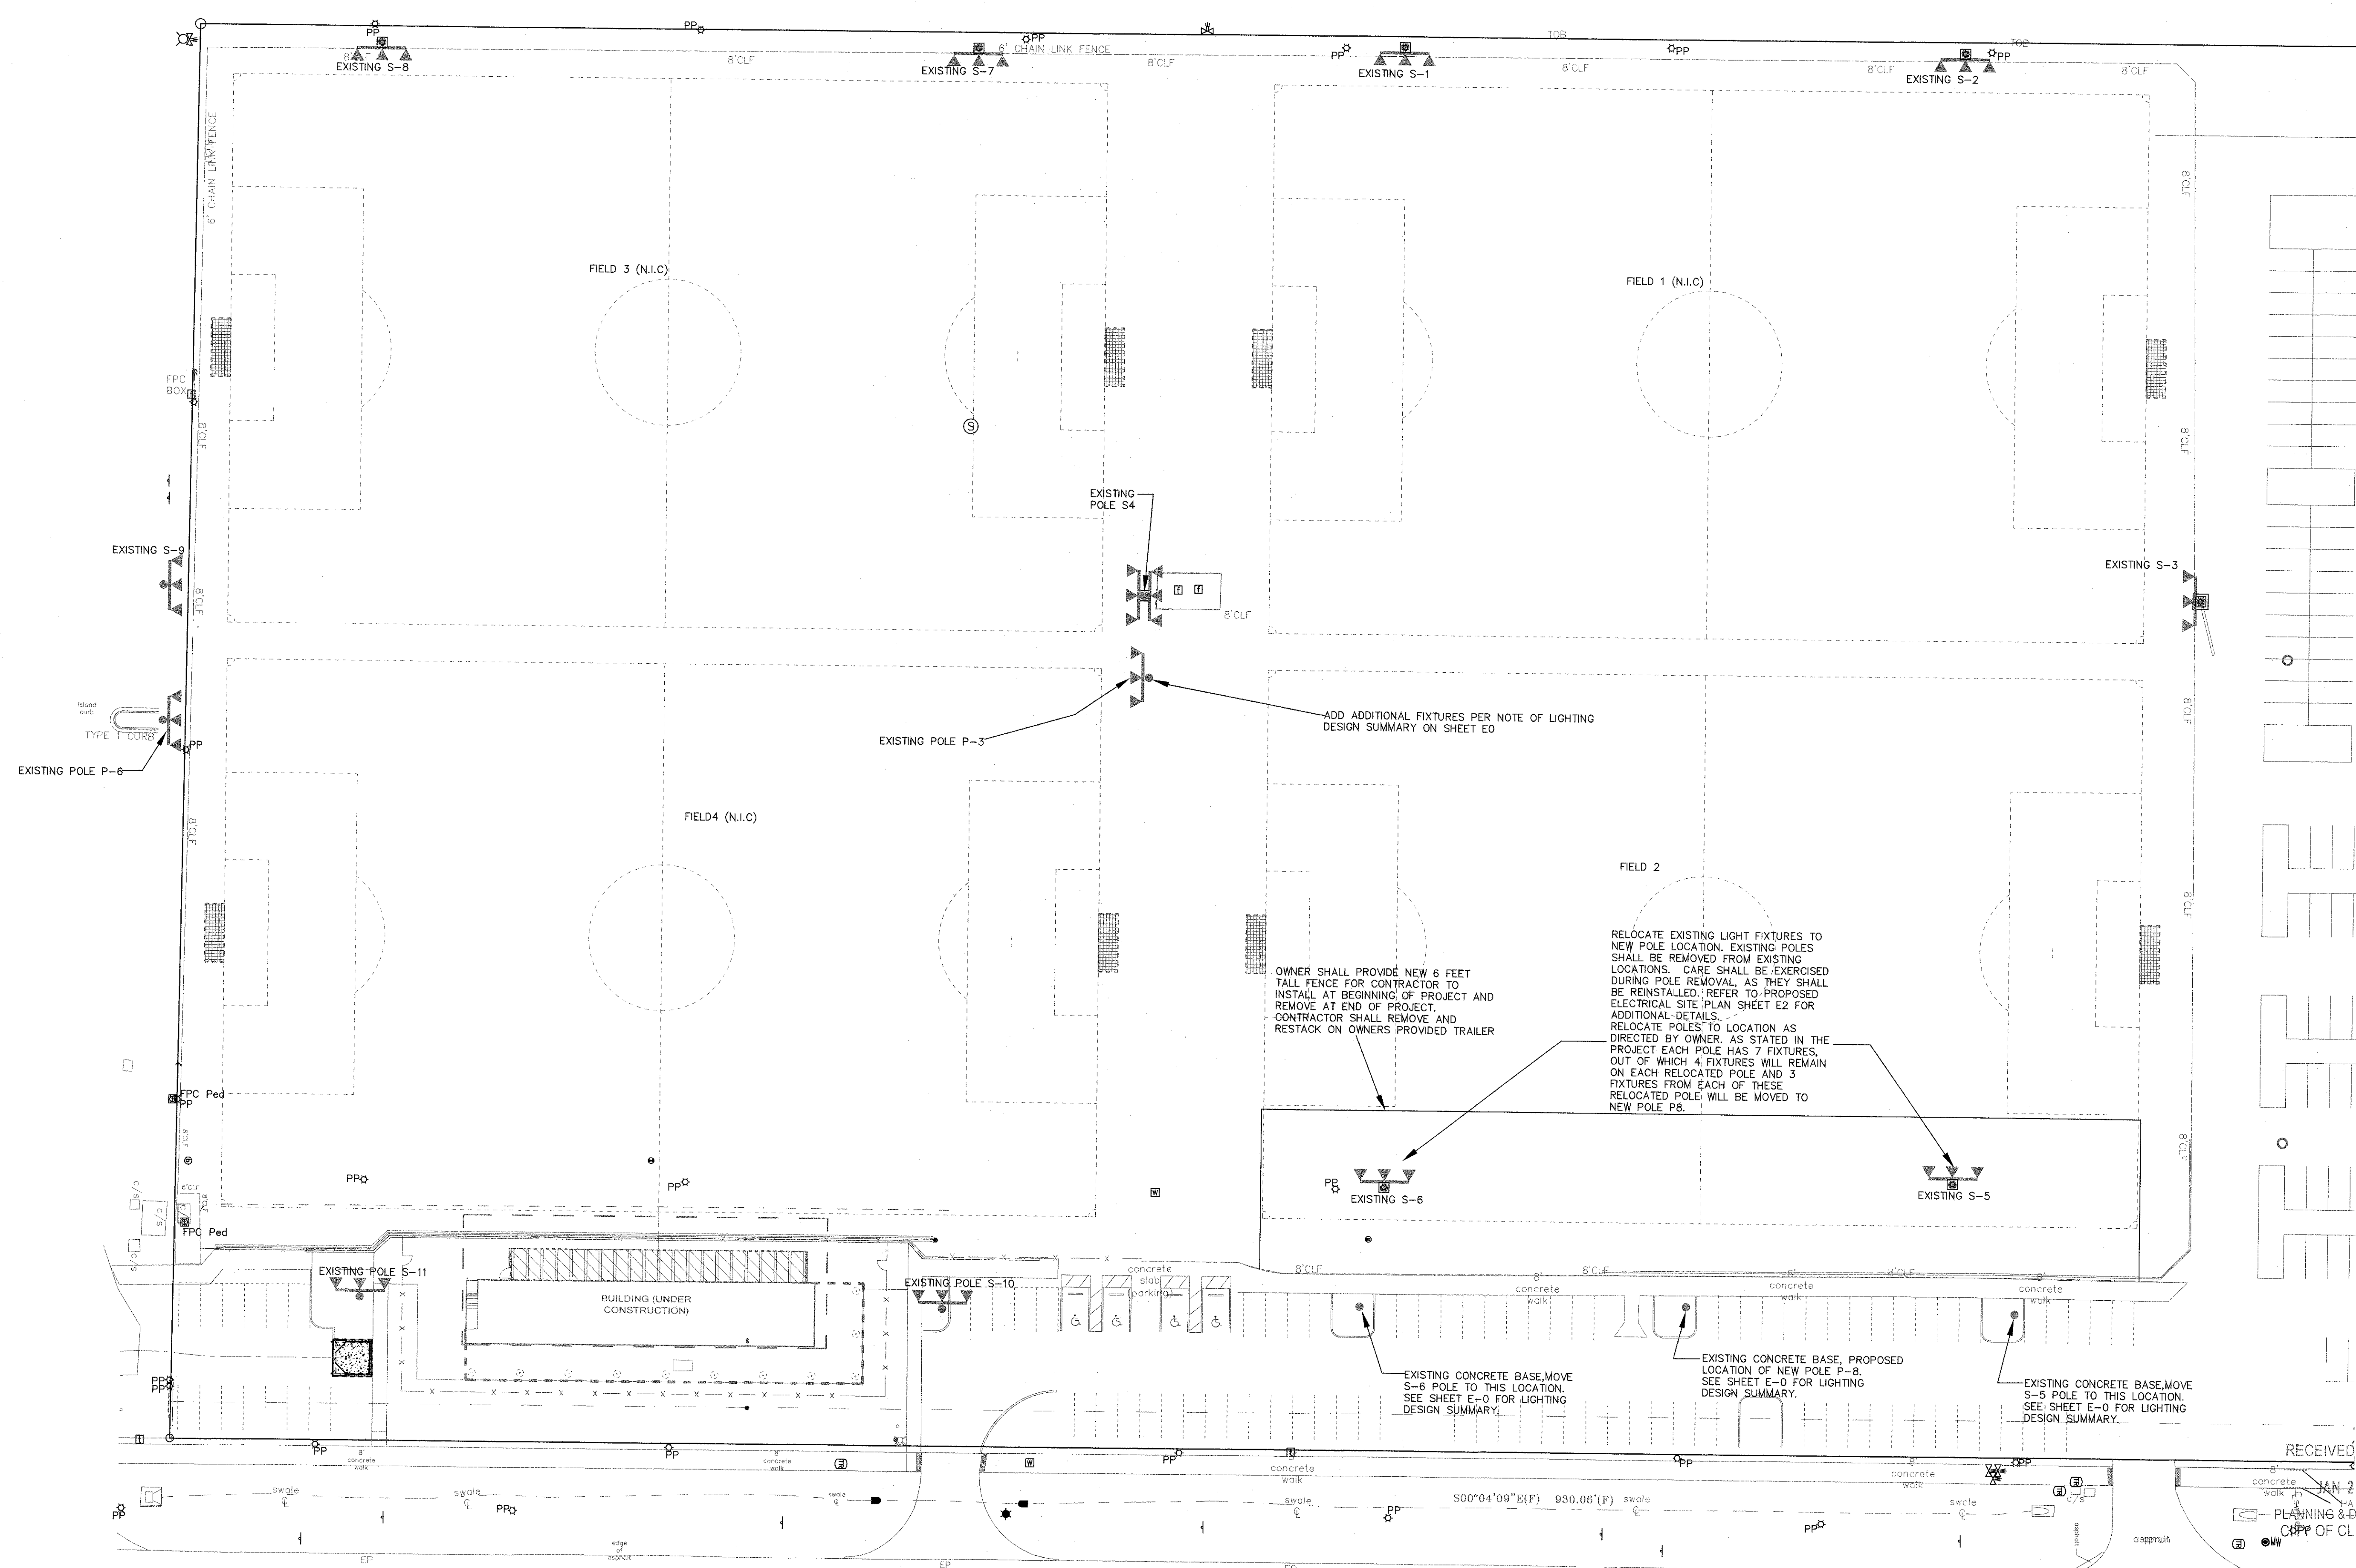


McMULLEN BOOTH ROAD
200' RIGHT-OF-WAY

ELECTRICAL EXISTING CONDITION- DEMO PLAN
SCALE: 1" = 40'-0"

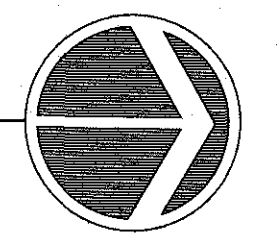


RECEIVED BY: J.A.W.
JAN 28 2021
PLANNING & DEVELOPMENT
CITY OF CLEARWATER


RECORD DRAWINGS	
SURVEYED BY	DRAWN BY
REVIEWED BY	PROJECT ENGINEER
DATE	DATE
APPROVED BY	CITY ENGINEER MICHAEL D. QUILLEN, P.E. # 33721
DATE	DATE
REVISION	
BY	DATE



CITY OF CLEARWATER, FLORIDA
PARKS & RECREATION DEPT.
100 S. Myrtle Ave.
Clearwater, FL 33756



GRINER ENGINEERING, INC.
1628 First Avenue North
St. Petersburg, Florida 33713
Phone: (727)-822-2335
Fax: (727)-821-3361
Certificate of Authorization #3173

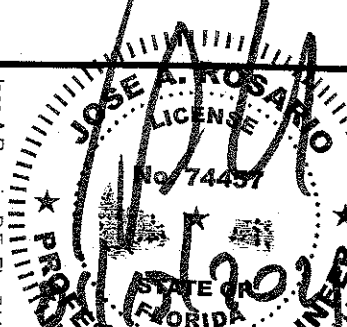

JOSE A. ROSARIO
P.E. 74457
FLORIDA

COUNTRYSIDE SPORTS COMPLEX
FIELD 2 RENOVATION

DRAWN BY	SK/JAR	DESIGNED BY	CLEARWATER	CHECKED BY	JAR	CLEARWATER CONTRACT NO.
SCALE	NONE	SURVEYED BY	CLEARWATER	BOOK NO.		CLEARWATER JOB NO.
HORIZ.	1"=N/A	DATE DRAWN	Dec 04, 2020	DWG NAME	2020-XXXX	SHEET NO. 2
JOSE A. ROSARIO, P.E. 74457						DATE


POLE FEEDER SCHEDULE

FEEDER LOAD PER PANEL SCHEDULE FOR EACH POLE. THE DATA BELOW WAS GENERATED FOLLOWING THE 2017 NATIONAL ELECTRIC CODE - NEC 210.19 (A)(1) INFORMATIONAL NOTE NO. 4

FIELD POLE	EST. DISTANCE (FT)	WIRE SIZE (COPPER)	CONDUIT SIZE (IN)	VOLTAGE DROP (%)
S5	640 FT	(4#2/0 + 1#6 EG)	3"	1.5%
S6	370 FT	(4#1 + 1#6 EG)	3"	1.3%
P3	75 FT	(4#3 + 1#8 EG)	3"	1.5%
P4	430 FT	(4#4/0 + 1#4 EG)	3"	2.2%
P8	490 FT	(4#4/0 + 1#4 EG)	3"	2.2%

ELECTRICAL LINES GUIDE

---	SPARE EXISTING CONDUIT FOR NEW & RELOCATED POLE LIGHTING
---	DIRECTIONAL BORING

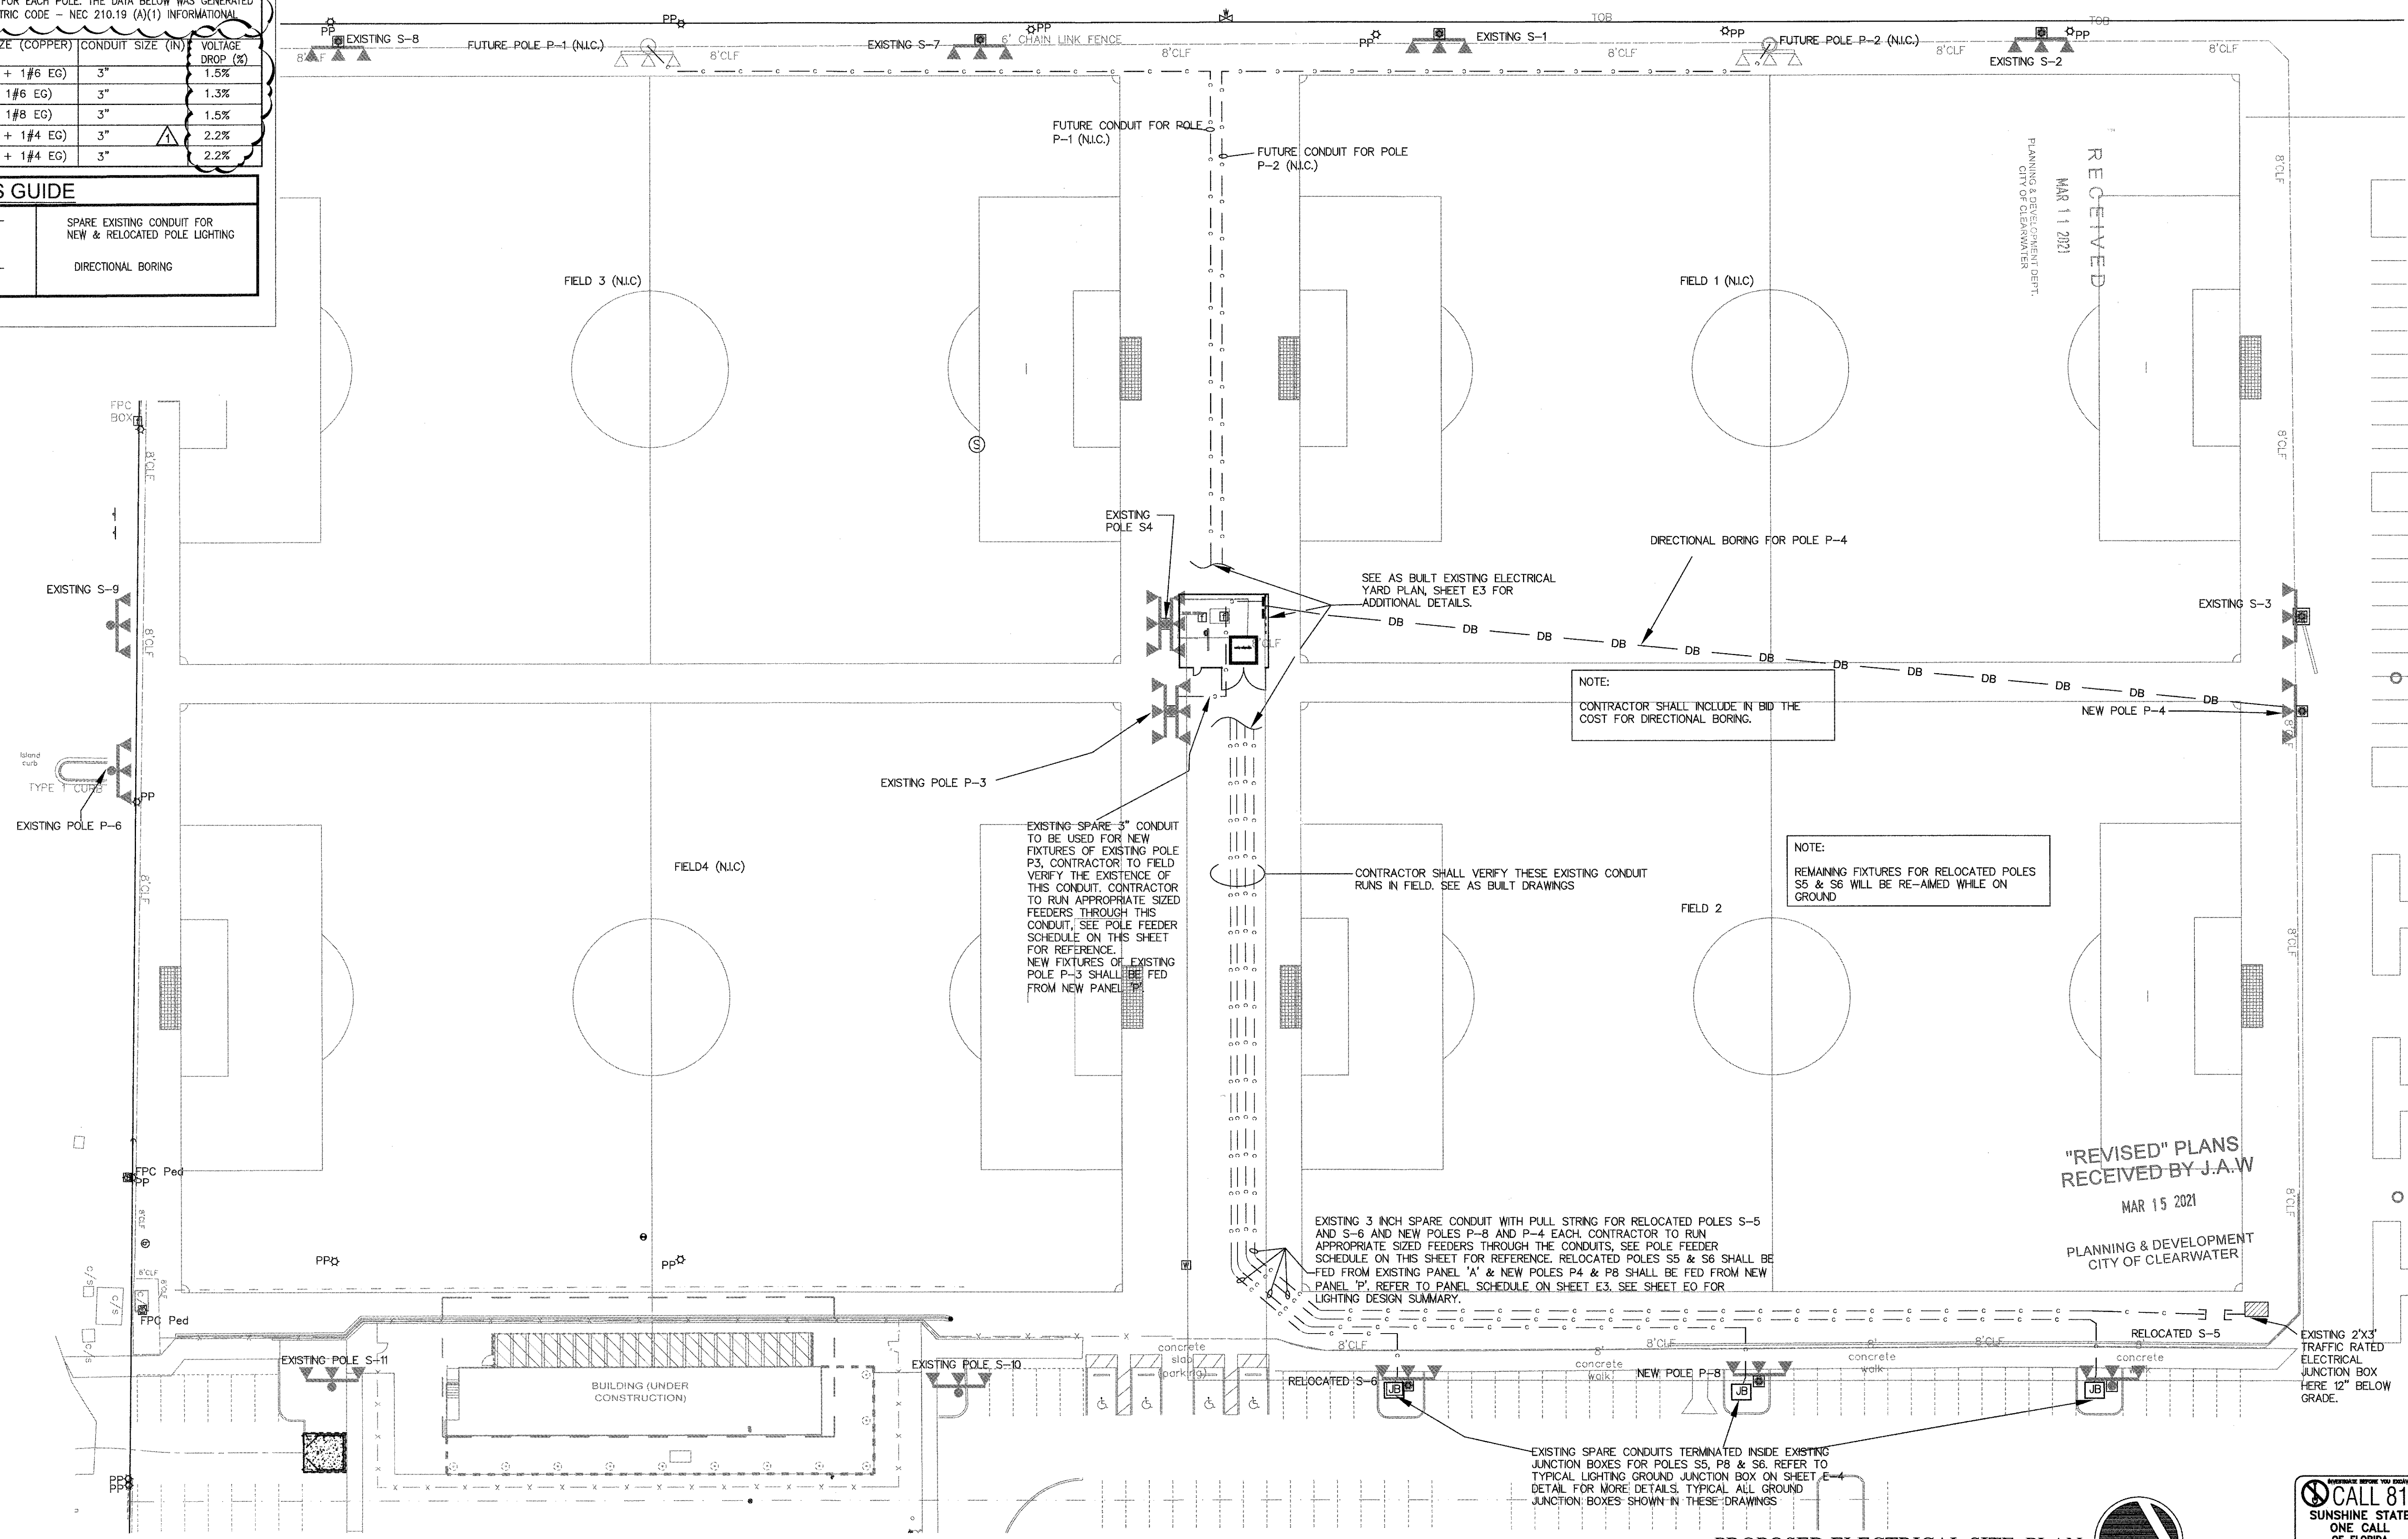

PROPOSED ELECTRICAL SITE PLAN

SCALE: 1" = 30'-0"

RECORD DRAWINGS	
SURVEYED BY	DRAWN BY
REVIEWED BY	PROJECT ENGINEER
APPROVED BY	CITY ENGINEER MICHAEL D. QUINN, P.E. # 33721

REVISION	
RESPONSE TO PERMIT COMMENTS	SK 3/1/21

CITY OF CLEARWATER, FLORIDA
PARKS & RECREATION DEPT.
100 S. Myrtle Ave.
Clearwater, FL 33756

GRINER
GRINER ENGINEERING, INC.
1628 First Avenue North
St. Petersburg, Florida 33713
Phone: (727) 822-2335
Fax: (727) 821-3361
Certificate of Authorization #3173

JOSEPH H. GRINER III
Professional Engineer
License # 33721

COUNTRYSIDE SPORTS COMPLEX
FIELD 2 RENOVATION

DRAWN BY SK	DESIGNED BY	CHECKED BY JHG	CLEARWATER CONTRACT NO.
SCALE VERT. NONE	SURVEYED BY Clearwater	BOOK NO.	CLEARWATER JOB NO.
HORIZ. 1"=N/A	DATE DRAWN Dec 04, 2020	DWG NAME 2020-XXXX	SHEET NO. 3
JOSEPH H. GRINER III, FL P.E. 39491			

CALL 811
SUNSHINE STATE
ONE CALL
OF FLORIDA
www.callsunshine.com
(800) 432-4770
Mon-Fri 8 AM - 5 PM
BEFORE YOU EXCAVATE

EXISTING PANEL 'A'				SURFACE MOUNTED 120/208 VOLT 3 PHASE 4 WIRE WITH GROUND										400 MCB 120/208V, 75C*				
VERIFY EX. AIC																		
WIR E	COND	LOAD TYPE	CKT. NO.	DESCRIPTION	BREAKER			A	B	C	BREAKER			DESCRIPTION	CKT. NO.	LOAD TYPE	COND. SIZE	WIRE SIZE
					TRIP	POLE	VOLT				VOLT	POLE	TRIP					
		L	1												2	L		
		L	3	EX POLE S1	60	3	208				208	3	100	EX POLE S3	4	L		
		L	5											6	L			
		L	7											8	L			
		L	9	EX POLE S2	60	3	208				208	3	100	EX POLE S4	10	L		
		L	11											12	L			
		L	13	EX 60 AMP CIRCUIT	60	2	208				120	1	20	EX 20 AMP CIRCUIT	14	L		
		L	15								120	1	20	EX 20 AMP CIRCUIT	16	L		
		L	17	EX 20 AMP CIRCUIT	20	1	120				120	1	20	EX 20 AMP CIRCUIT	18	L		
		L	19											20	L			
		L	21	RELOCATED POLE S5	40	3	208				120	3	40	RELOCATED POLE S6	22	L		
		L	23											24	L			
		L	25	EX 20 AMP CIRCUIT	20	1	120				120	1	20	EX 20 AMP CIRCUIT	26	L		
		L	27	EX 20 AMP CIRCUIT	20	1	120							28	L			
		L	29											30	L			
		L	31											32	L			
		L	33											34	L			
		L	35											36	L			
		L	37											38	L			
		L	39								208	3		SURGE PROTECTION	40	L		
		L	41											42	L			
CONNECTED VA								0	0	0								
CONNECTED PHASE AMPS								0	0	0								
PHASE BALANCE								33.33%	33.33%	33.33%	100%							
LOAD TYPE				CONNECTED				NEC DEMAND				DEMAND LOAD						
L	LIGHTING			0				1.25				0	VA					
R	RECEPTACLES			0				1				0	VA					
AC	AIR CONDITIONING			0				0				0	VA					
H	HEATING			0				0				0	VA					
M	MISC. NON-CONTINUOUS			0				1				0	VA					
C	CONTINUOUS			0				1.25				0	VA					
K	KITCHEN			0				0.65				0	VA					
								TOTAL				0	VA					
				120/208V, 3 PHASE								AMPS						
1.00 P.F. CORRECTION																		
Refer to Electrical Load Summary on this sheet																		

NEW PANEL 'P'				SURFACE MOUNTED 120/208 VOLT 3 PHASE 4 WIRE WITH GROUND										400 MCB 120/208V, 75C*							
35,000 AIC																					
WIR E	COND TYPE	LOAD TYPE	CKT. NO.	DESCRIPTION	BREAKER			A		B		C		BREAKER			DESCRIPTION	CKT. NO.	LOAD TYPE	COND. SIZE	WIRE SIZE
					TRIP	POLE	VOLT						VOLT	POLE	TRIP						
		L	1					8262	10328								2	L			
		L	3	NEW POLE (P8)	100	3	208			8262	10328		208	3	100	EX POLE (P3B)	4	L			
		L	5									8262	10328				6	L			
		L	7					9295					120	1	20	SPARE	8	L			
		L	9	NEW POLE (P4)	100	3	208			9295			120	1	20	SPARE	10	L			
		L	11									9295	120	1	20	SPARE	12	L			
			13	SPARE	20	1	120										14				
			15	SPARE	20	1	120										16				
			17	SPARE	20	1	120										18				
			19														20				
			21														22				
			23														24				
			25														26				
			27														28				
			29														30				
			31														32				
			33														34				
			35														36				
			37														38				
			39										208	3		SURGE PROTECTION	40				
			41														42				
CONNECTED VA								27885		27885		27885									
CONNECTED PHASE AMPS								101		101		101									
PHASE BALANCE								33.33%		33.33%		33.33%		100%							
LOAD TYPE								CONNECTED		NEC DEMAND		DEMAND LOAD									
L LIGHTING								83655		1.25		104569		VA							
R RECEPTACLES								0		1		0		VA							
AC AIR CONDITIONING								0		0		0		VA							
H HEATING								0		0		0		VA							
M MISC. NON-CONTINUOUS								0		1		0		VA							
C CONTINUOUS								0		1.25		0		VA							
K KITCHEN								0		0.65		0		VA							
										TOTAL		104569		VA							
								120/208V, 3 PHASE				291 AMPS		1.00 P.F. CORRECTION							

LOAD SUMMARY OF EXISTING PANEL 'A':

- NO NEW LOADS ADDED FOR EXISTING PANEL
- INSTEAD, 3 FIXTURES HAS BEEN REDUCED FROM EACH RELOCATED POLES S5 & S6
- HENCE THERE WOULD BE OVERALL DECREASE IN LOAD FOR PANEL 'A'

NOTES FOR PANEL 'A':


- BOTH THE 60 AMP BREAKERS FOR POLES S5 AND S6 SHALL BE REPLACED BY 3 POLE 40 AMP BREAKERS.
- THE NEW 40 AMP BREAKERS SHALL MATCH THE MANUFACTURER & AIC RATING OF PANEL 'A'.

SITE PLAN GENERAL NOTES:

- THIS CONTRACTOR SHALL REFER TO THE SITE UTILITIES PLAN FOR LOCATING ANY UNDERGROUND UTILITIES PRIOR TO THE COMMENCEMENT OF WORK.
- BURIED UTILITIES AND/OR STRUCTURES MAY EXISTS ON THIS SITE. EXTREME CAUTION MUST BE USED IN ANY WORK WHICH MAY CONFLICT WITH ANY UNDERGROUND UTILITIES OR STRUCTURES, COORDINATE WITH OWNER.
- ANY CONFLICTS SHOULD BE RESOLVED IN WRITING WITH THE CIVIL ENGINEER AND GENERAL CONTRACTOR BEFORE PRECEDING WITH ANY UNDERGROUND ACTIVITY.
- ALL EXCAVATION FOR THE ELECTRICAL WORK ON THIS SHEET SHALL BE DONE EXERCISING CAUTION AND BE WATCHFUL OF UNEXPECTED ITEMS.
- CONTRACTOR TO SAFELY REMOVE EXISTING, LIGHTING POLES, FIXTURES, WIRING AND CONDUITS TO THE NEAREST POINT OF CONNECTION. CONTRACTOR WILL SAFELY STORE ALL REMOVED ITEMS AND DISPOSE OF THEM.
- CONTRACTOR SHALL BE RESPONSIBLE FOR SCHEDULING WORK WHILE KEEPING THE FUNCTIONALITY OF THE FIELD FACILITIES AT ALL TIMES. POWER SHUTDOWNS SHALL BE COORDINATED WITH THE CITY & ONLY AS SWITCHOVER. PREPARATION WORK SHALL BE PERFORMED IN ADVANCE IN ORDER TO MINIMIZE DOWN TIME DUE TO ELECTRICAL POWER SHUT DOWN.
- DIMENSION OF ELECTRICAL GEAR SHALL BE FIELD VERIFIED PRIOR ELECTRICAL ROUGH IN. IN CASE ANY ISSUES ARE FOUND, THE EOR/OWNER SHALL BE NOTIFIED IN WRITING AND A SOLUTION SHALL BE APPROVED PRIOR ROUGH IN COMMENCEMENT.
- EXISTING PLAY FIELD SHALL CONTINUE WITH ITS PROGRAMMED ACTIVITIES. DISRUPTION SHALL BE KEPT TO A MINIMUM. SWITCHOVER TO NEW TRANSFORMER FROM EXISTING SHALL BE COORDINATED WITHIN 24 HOURS OF DOWN TIME & ADVANCE NOTICE IN CONSTRUCTION SCHEDULE & PROGRESS MEETINGS. COORDINATE WITH OWNER PROGRAM STAFF.


REVISED LOAD SUMMARY

DECREASE IN LOAD ON EXISTING PANEL A 12 KVA OR 35 AMP (120/208V, 3 PHASE)
INCREASE IN LOAD ON NEW PANEL 'P' 104.5 KVA OR 291 AMP (120/208V, 3 PHASE)
PER AS BUILT PHASE I DRAWINGS EXISTING 800 AMP FEEDERS WERE RUN FROM THE EXISTING TRANSFORMER TO THE EXISTING WIREWAY FEEDING EXISTING PANEL 'L' AND NEW PANEL 'P'.

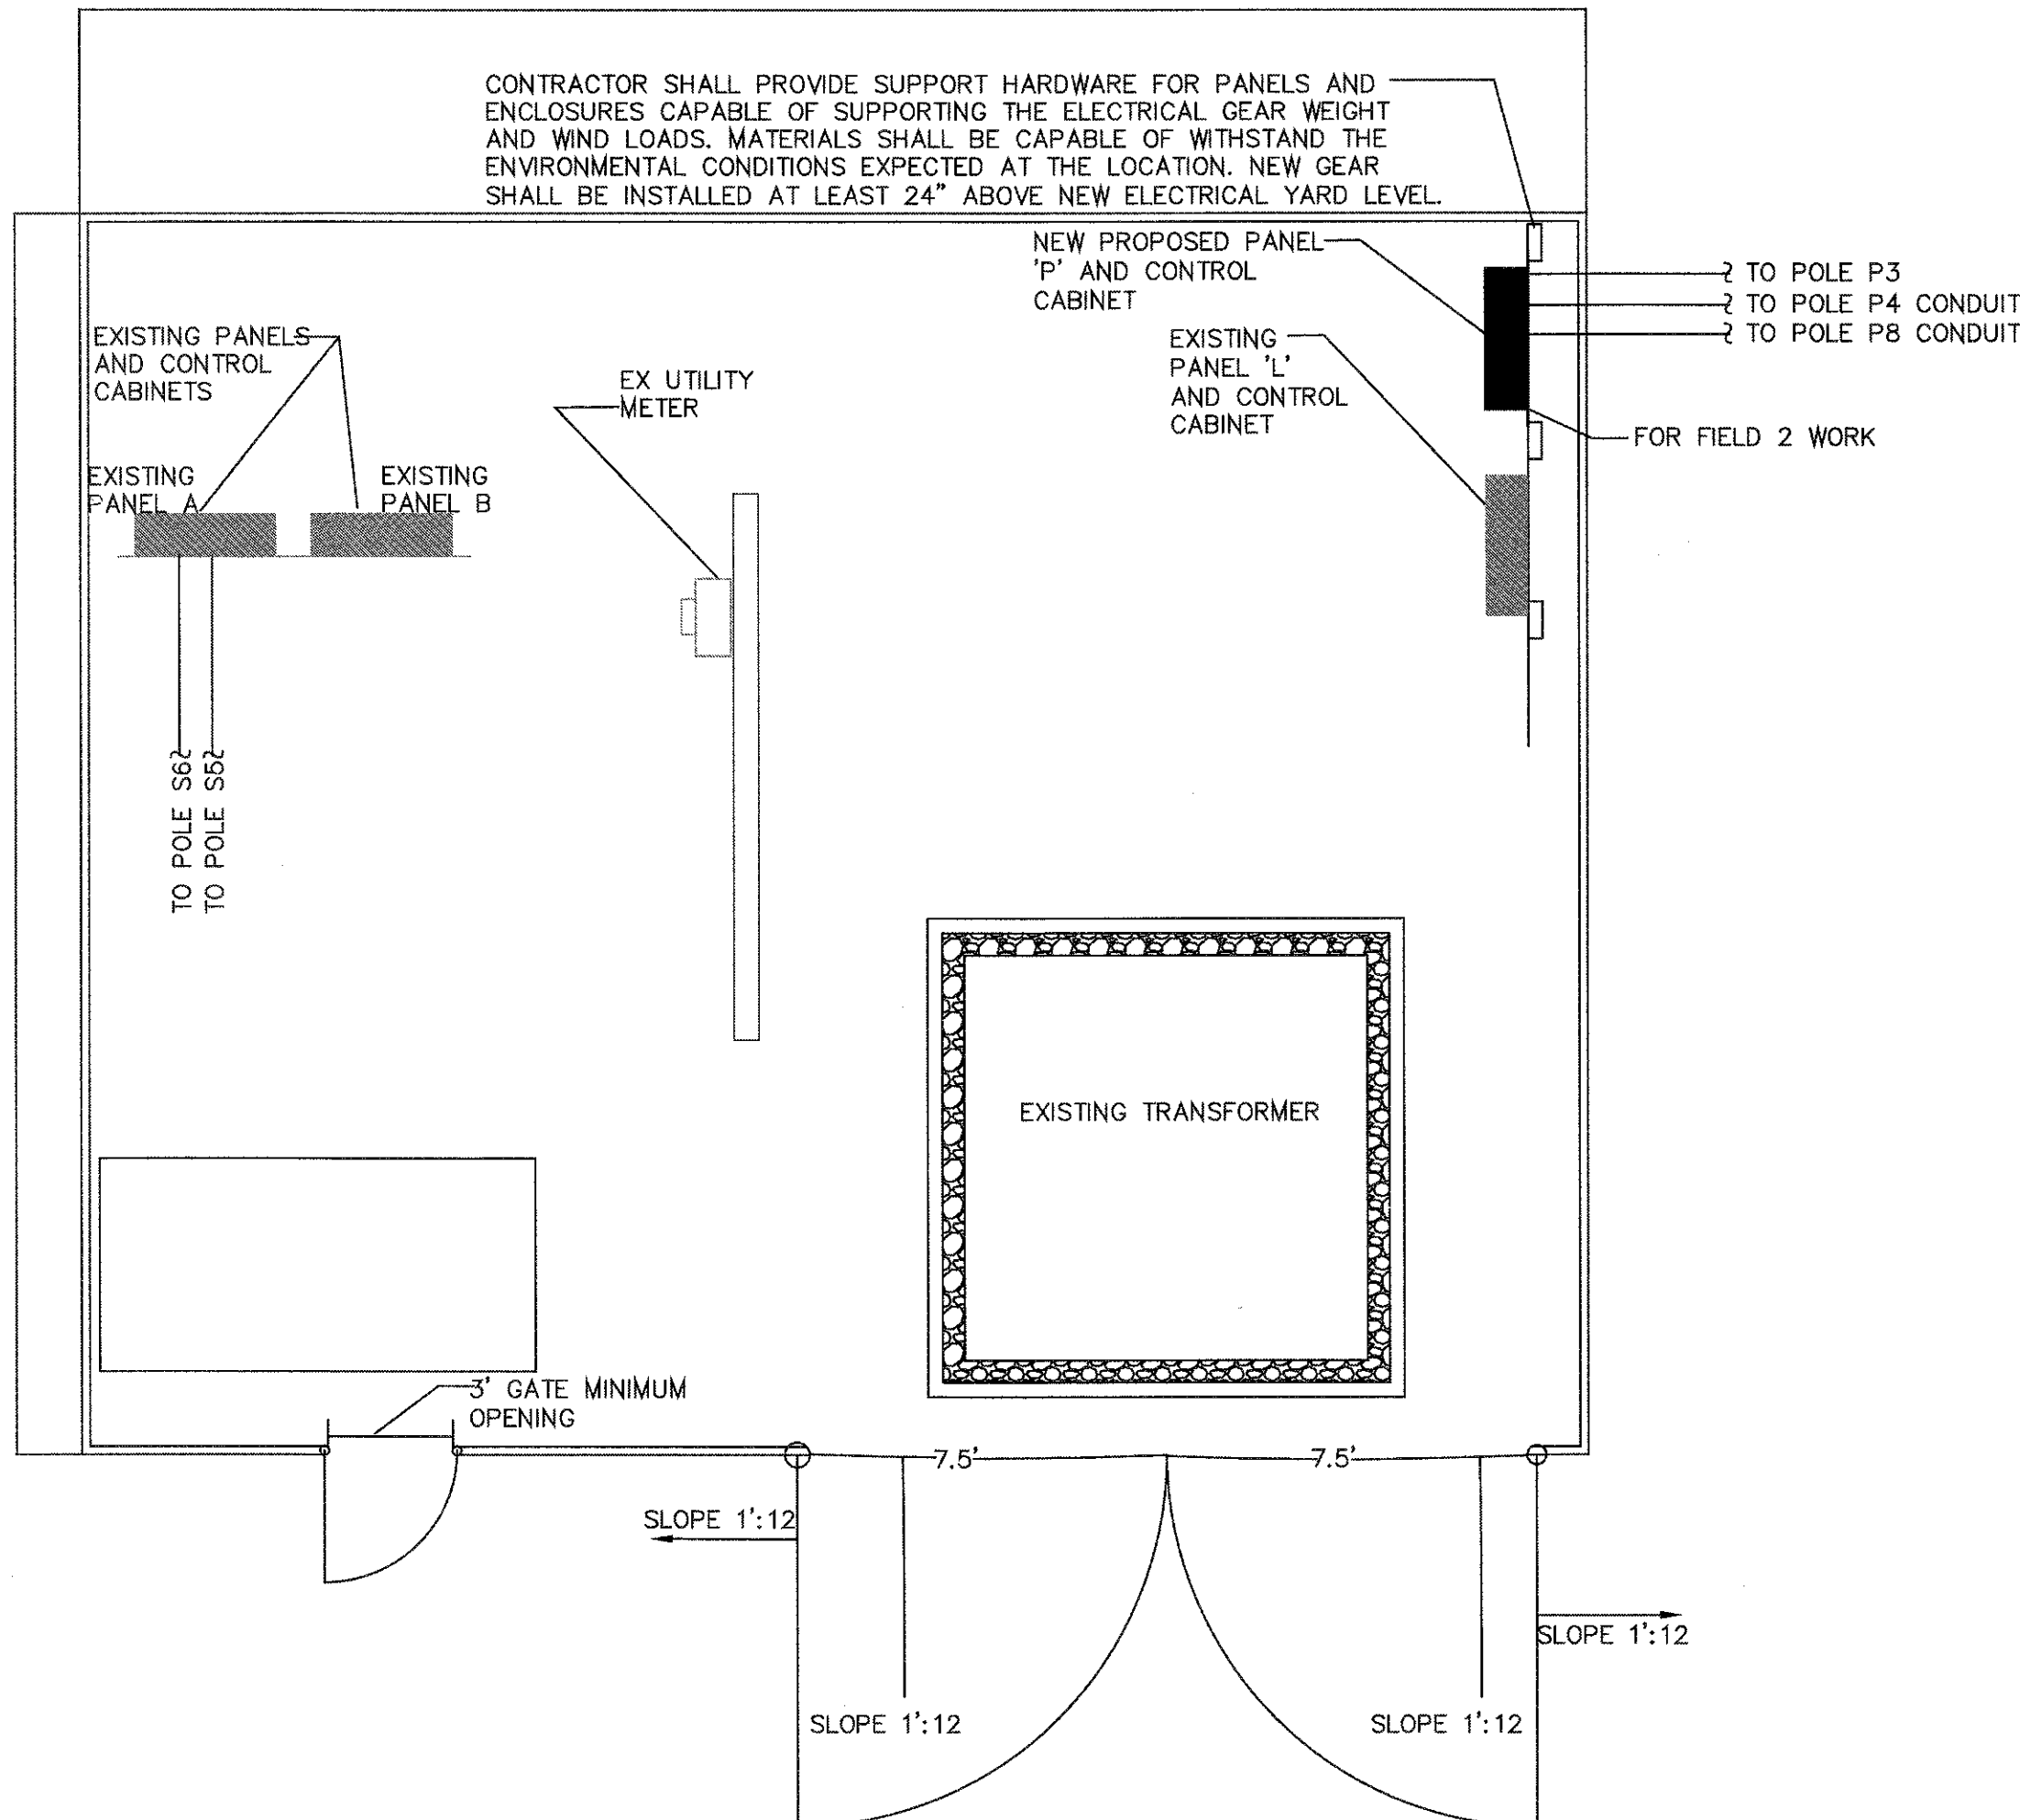

ENLARGED REVISED ELECTRICAL YARD PLAN

SCALE: 1/4" = 1'-0"

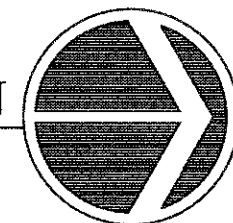

RECEIVED BY: J.A.W

JAN 28 2021

PLANNING & DEVELOPMENT
CITY OF CLEARWATER


RECORD DRAWINGS																	
SURVEYED BY	DRAWN BY																
REVIEWED BY	PROJECT ENGINEER	DATE															
APPROVED BY	CITY ENGINEER MICHAEL D. OULLEN, P.E. # 33721	DATE															
		REVISION	BY	DATE													

CITY OF CLEARWATER, FLORIDA
PARKS & RECREATION DEPT.
100 S. Myrtle Ave.
Clearwater, FL 33756

GRINER ENGINEERING, INC.
1628 First Avenue North
St. Petersburg, Florida 33713
Phone: (727)-822-2335
Fax: (727)-821-3361
Certificate of Authorization #3173

COUNTRYSIDE SPORTS COMPLEX
FIELD 2 RENOVATION

DRAWN BY	SK/JAR	DESIGNED BY	JAR	CHECKED BY	JAR	CLEARWATER CONTRACT NO.	
SCALE	NONE	SURVEYED BY	Clearwater	BOOK NO.		CLEARWATER JOB NO.	
HORIZ.	1"=N/A	DATE DRAWN	Dec 04, 2020	DWG NAME	2020-XXXX	SHEET NO.	4
JOSE A ROSARIO, P.E. 74457						DATE	

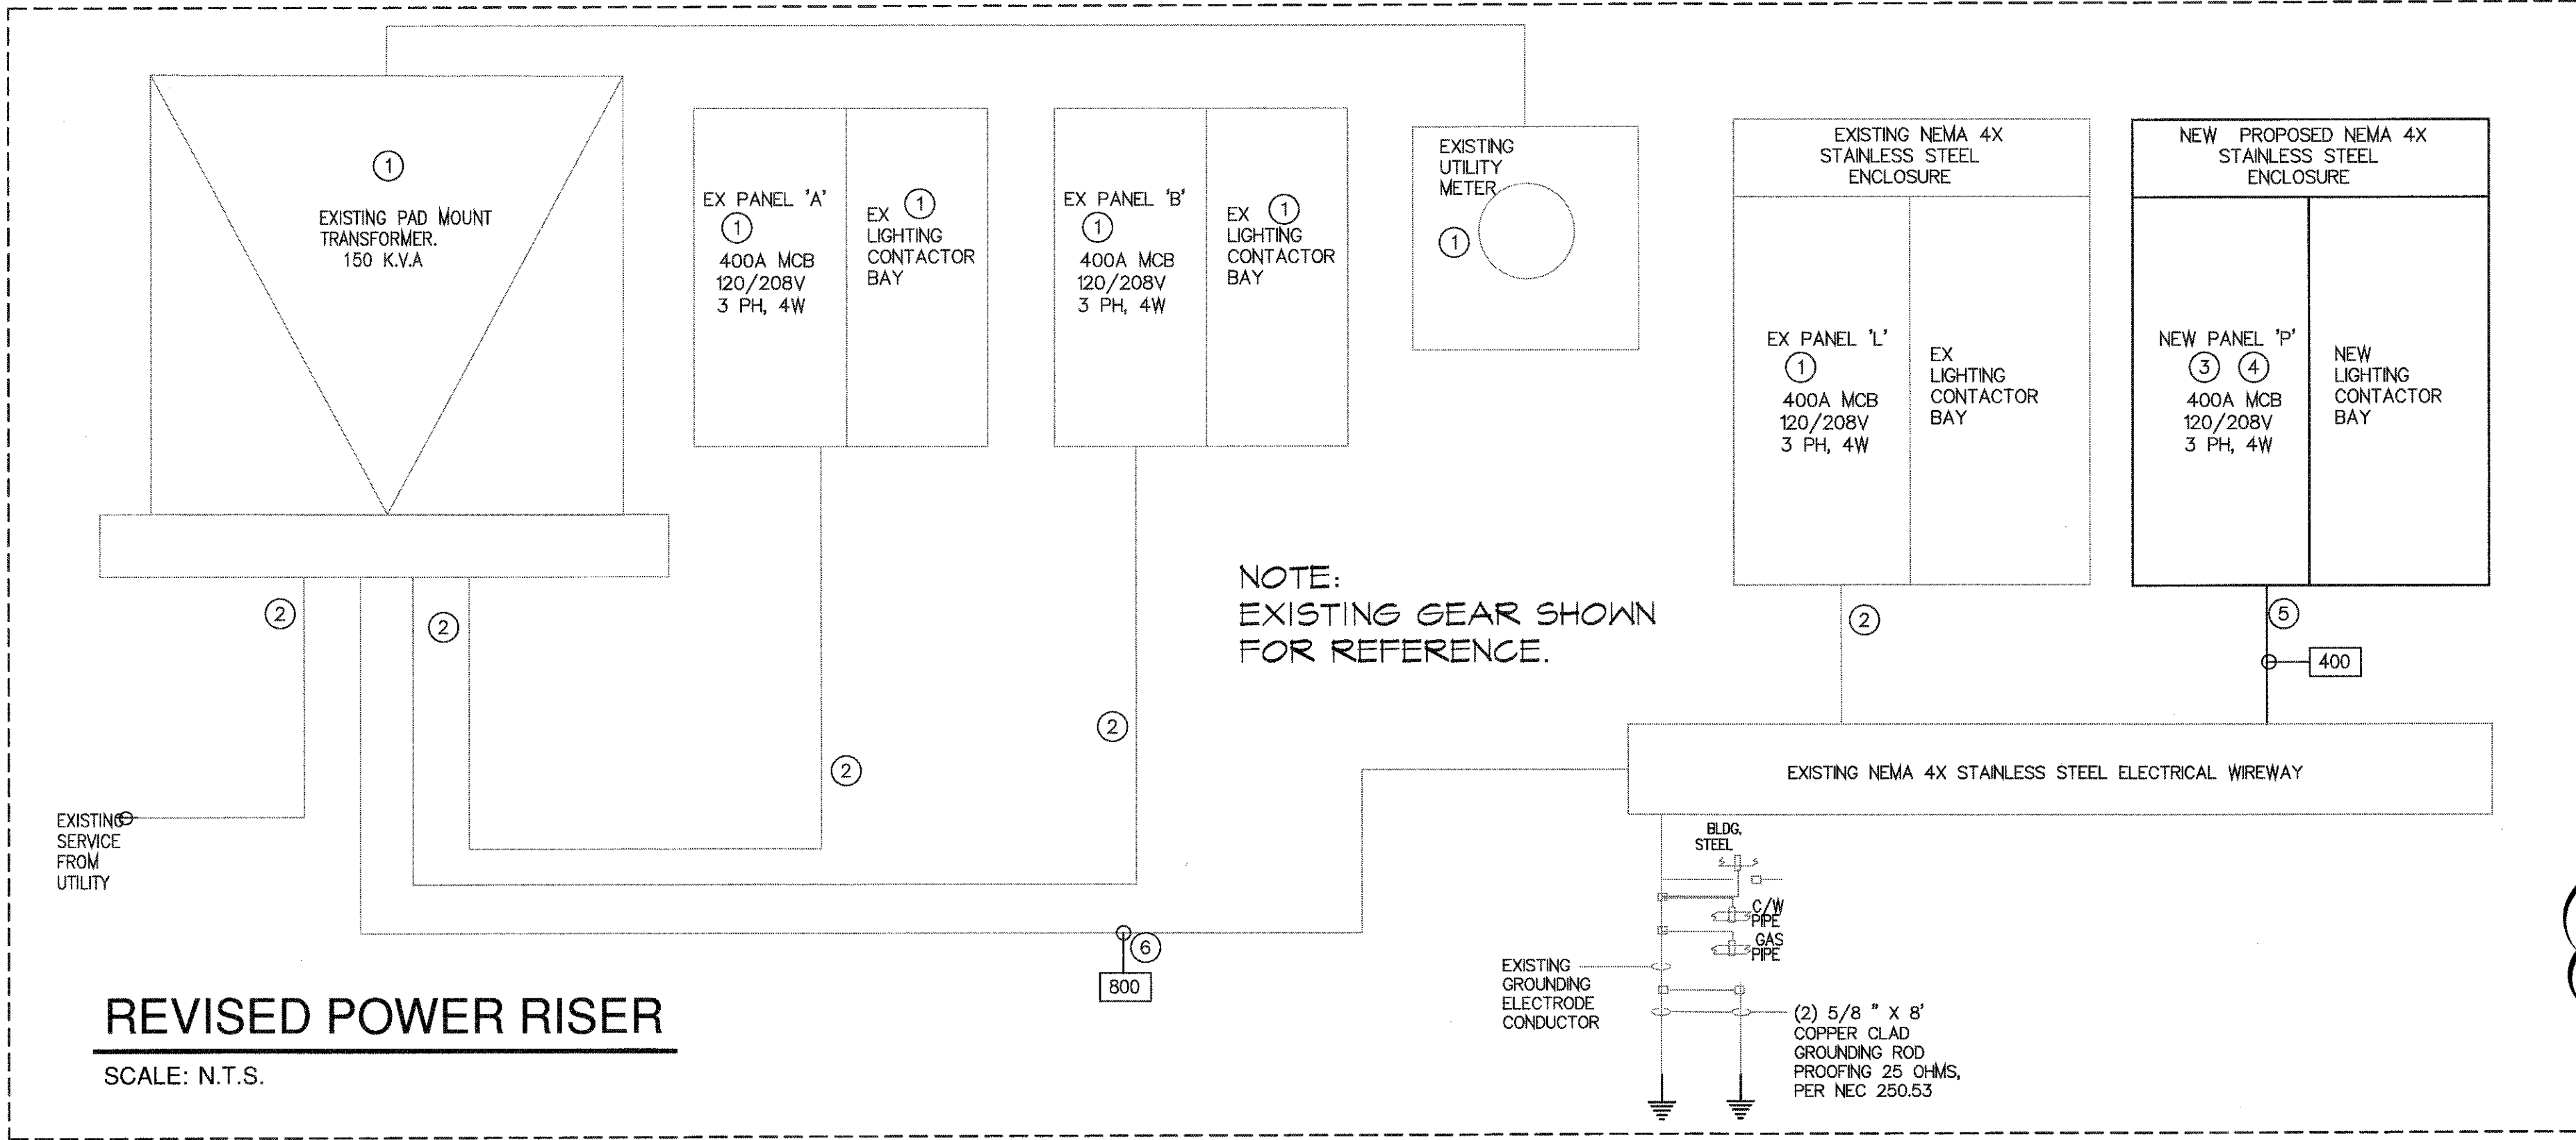

- GENERAL NOTES:**
- ELECTRICAL CONTRACTOR TO VERIFY EXISTING CONDITIONS AND TO REPORT TO GENERAL CONTRACTOR, OWNER AND ENGINEER ANY DISCREPANCY FROM THAT SHOWN ON DRAWINGS.
 - COORDINATE ALL NEW ELECTRICAL WORK WITH CIVIL DRAWINGS GENERAL CONTRACTOR AND OWNER.
 - PANELS ARE REQUIRED TO HAVE AN PANELBOARD NAMEPLATE PER NEC 408.4(B) SEE TYPICAL PANELBOARD NAMEPLATE DETAILS (THIS SHEET) FOR MORE INFORMATION

- RISER DIAGRAM NOTES:**
- EXISTING TRANSFORMER, EXISTING METER, EXISTING LIGHTING CONTACTORS AND EXISTING PANELS TO REMAIN. CONTRACTOR TO VERIFY THE RATINGS OF THESE EXISTING EQUIPMENTS.
 - EXISTING FEEDERS TO REMAIN. VERIFY EXISTING FEEDERS TO VERIFY CURRENT CAPACITY.
 - PROVIDE 1 NEW 400 AMPS M.C.B PANEL 'P' AND NEW LIGHTING CONTACTOR.
 - CONTRACTOR SHALL FURNISH AND INSTALL SURGE SUPPRESSION FOR ALL PANELS FOR PANEL AMPERAGE AND VOLTAGE AVAILABLE AT THE PANEL
 - RUN 400 AMP FEEDERS AS SHOWN ON THE RISER DIAGRAM.
 - CONTRACTOR SHALL ENSURE AT LEAST (3) 3" CONDUITS ARE RUN FROM THE EXISTING PAD MOUNT TRANSFORMER TO THE EXISTING WIREWAY. CONTRACTORS SHALL ALSO ENSURE 800 AMP FEEDERS TO BE USED FROM THE TRANSFORMER TO THE WIREWAY AS SHOWN ON THE FEEDER SCHEDULE.

FAULT CURRENT

UTILITY TRANSFORMER VOLTAGE	120/208V 3 PH
NEW TRANSFORMER BANK SIZE	300KVA
AFC AT TRANSFORMER	23,800 AMPS
BUS	AVAILABLE FAULT CURRENT
PANEL 'P'	21,290 AMPS
	35000 AMPS MIN.

* LOAD CONTRIBUTION HAS BEEN ALLOCATED TO TOTAL FAULT CURRENT

AIC - AMPERAGE INTERRUPTING CAPACITY

SERVICE VOLTAGE DROP

BRANCH CIRCUITS LOADED PER NEC AMPACITY WITH RUNS LESS THAN 75 FEET SHOULD PROVIDE ACCEPTABLE VOLTAGE DROPS PER INTERNATIONAL BUILDING CODE (CURRENT ADOPTED EDITION). CONTRACTOR SHALL INCREASE THE SIZE BY 1 NOMINAL SIZE PER EACH 50 FEET OF WIRING.

GENERAL INTERNATIONAL BUILDING CODE NOTES:

ALL ELECTRICAL WORK SHALL COMPLY WITH INTERNATIONAL BUILDING CODE C405.6.3 VOLTAGE DROP

THE CONDUCTORS FOR FEEDERS AND BRANCH CIRCUITS COMBINED SHALL BE SIZED FOR A MAXIMUM OF 5 PERCENT VOLTAGE DROP TOTAL.

- GENERAL NOTES:**
- ELECTRICAL CONTRACTOR TO VERIFY EXISTING CONDITIONS AND TO REPORT TO GENERAL CONTRACTOR, OWNER AND ENGINEER ANY DISCREPANCY FROM THAT SHOWN ON DRAWINGS.
 - COORDINATE ALL NEW ELECTRICAL WORK WITH MECHANICAL CONTRACTOR AND OWNER.
 - PANELS ARE REQUIRED TO HAVE AN PANELBOARD NAMEPLATE PER NEC 408.4(B) SEE TYPICAL PANELBOARD NAMEPLATE DETAILS SHEET E300 FOR MORE INFORMATION

Control System Summary



Countryside Athletic Complex Phase 3 / 208806 - 208806B Soccer 1-2 - Page 4 of 4

PANEL SUMMARY

CABINET #	CONTROL MODULE LOCATION	CONTACTOR ID	CIRCUIT DESCRIPTION	PHASE LOAD AMPS	DISTRIBUTION PANEL ID (BY OTHERS)	CIRCUIT BREAKER POSITION (BY OTHERS)
1	1	C1	Pole S1	43.00		
1	1	C2	Pole S2	43.00		
1	1	C3	Pole S3	77.40		
1	1	C4	Pole S4	68.80		
1	1	C5	Pole S5	25.00		
1	1	C6	Pole S6	25.00		
2	1	C7	Pole P3	86.00		
2	1	C8	Pole P4	77.40		
2	1	C9	Pole P8	68.80		

ZONE SCHEDULE

ZONE	SELECTOR SWITCH	ZONE DESCRIPTION	POLE ID	CIRCUIT DESCRIPTION
Zone 1	1	Soccer 1-2	S1	C1
			S2	C2
			S3	C3
			S4	C4
			S5	C5
			S6	C6
			P3	C7
			P4	C8
			P8	C9

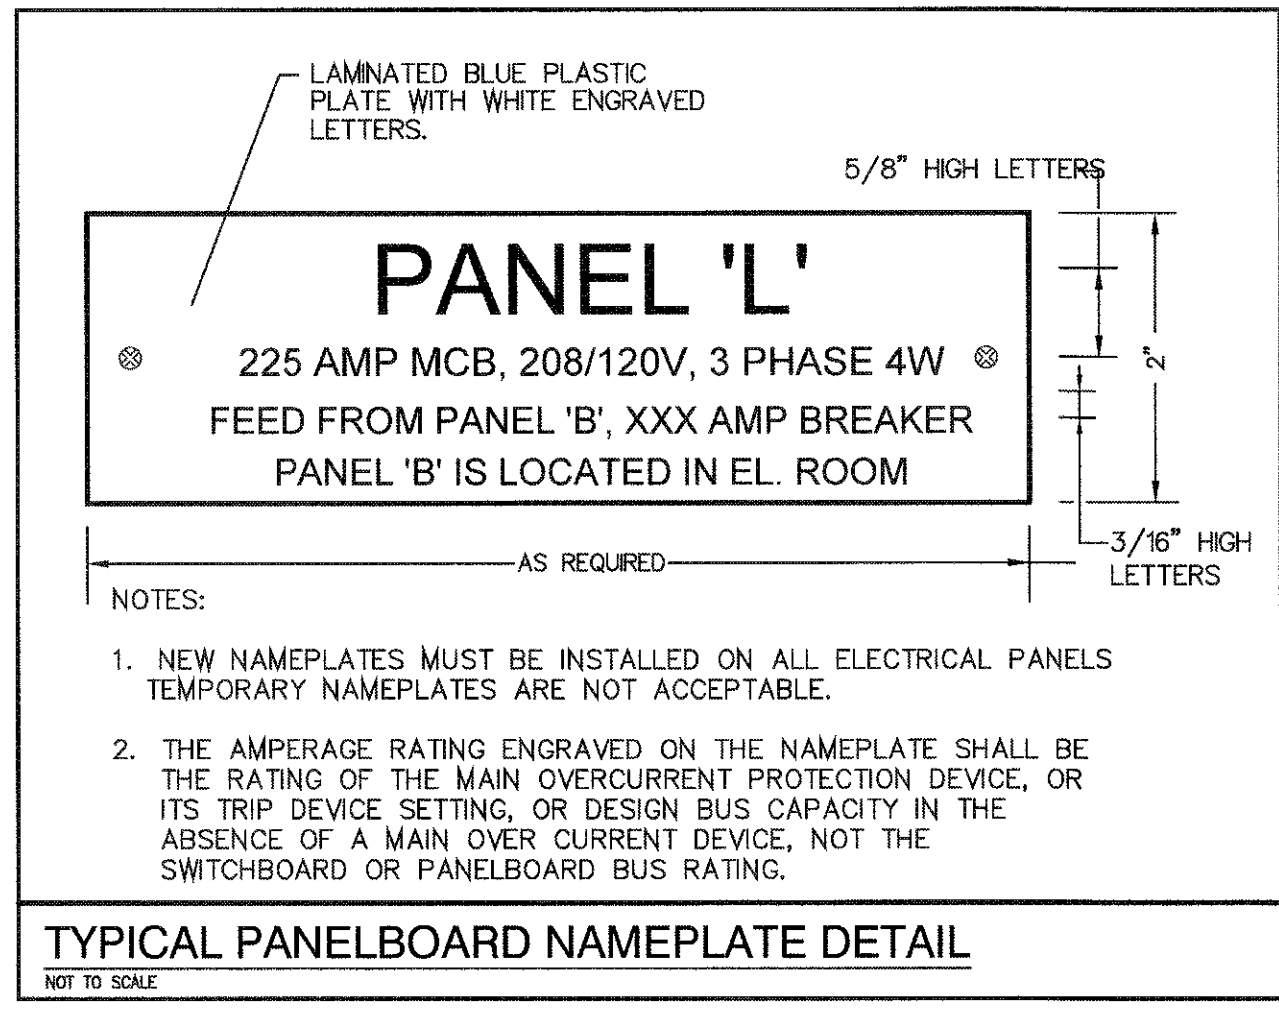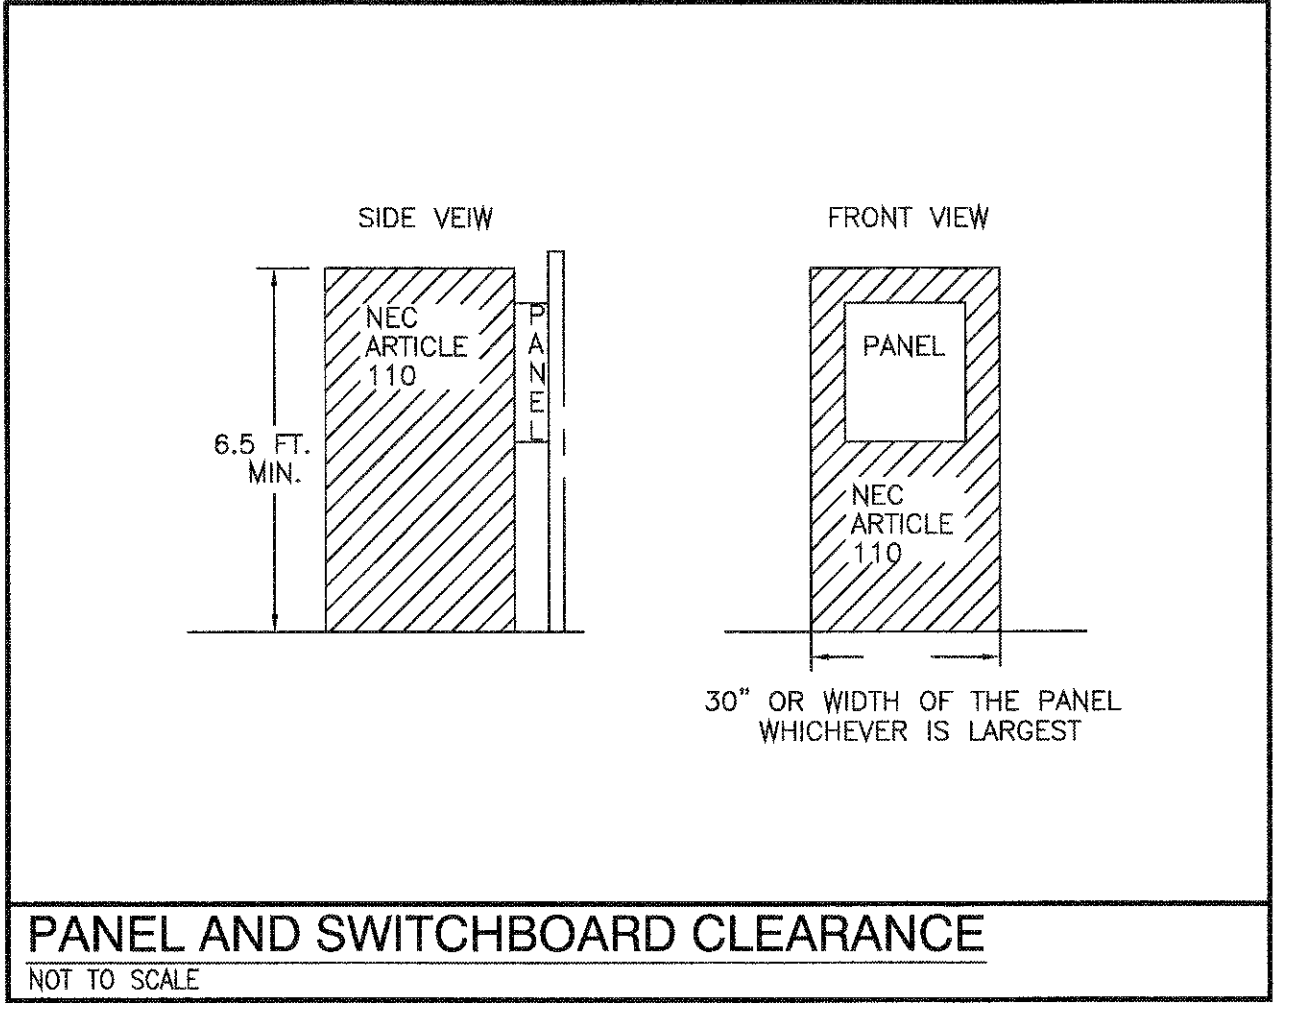



FEEDER SCHEDULES:


800S	(SERVICE - 800 AMPS) (3) SETS OF 4 #350 MCM, IN 3" C.	NOT APPLICABLE
800	(FEEDER - 800 AMPS) (3) SETS OF 4 #350 MCM, 1 #1/0 E.G. COPPER COND. IN 3" C.	NOT APPLICABLE
600	(FEEDER - 600 AMPS) (2) SETS OF 4 #350 MCM, 1 #1 E.G. COPPER COND. IN 2-1/2" C.	(FEEDER - 600 AMPS) (2) SETS OF 4 #500, 1 #2/0 E.G. ALUMINUM COND. IN 3" C.
400L	(FEEDER - 400 AMPS) (2) SETS OF 4 #3/0 AND 1 #3 E.G. COPPER COND. IN 2" C.	(FEEDER - 400 AMPS) (2) SETS OF 4 #250MCM AND 1 #1/0 E.G. ALUMINUM COND. IN 3" C.
400	(FEEDER - 400 AMPS) (2) SETS OF 4 #3/0 AND 1 #3 E.G. COPPER COND. IN 2" C.	(FEEDER - 400 AMPS) (2) SETS OF 4 #250MCM AND 1 #1/0 E.G. ALUMINUM COND. IN 3" C.
250	(FEEDER - 250 AMPS) 4 #350, AND 1 #4 E.G. COPPER COND. IN 3" C	(FEEDER - 250 AMPS) 4 #500, AND 1 #3/0 E.G. ALUMINUM COND. IN 3-1/2" C
200	(FEEDER - 200 AMPS) 4 #4/0 AND 1 #4 E.G. COPPER COND. IN 2-1/2" C	(FEEDER - 200 AMPS) 4 #350 AND 1 #1/0 E.G. ALUMINUM COND. IN 3" C
175	(FEEDER - 175 AMPS) 4 #3/0 AND 1 #6 E.G. COPPER COND. IN 2" C	(FEEDER - 175 AMPS) 4 #250 AND 1 #4 E.G. ALUMINUM COND. IN 2-1/2" C
125	(FEEDER - 125 AMPS) 4 #1/0 AND 1 #6 E.G. COPPER COND. IN 2" C	(FEEDER - 125 AMPS) 4 #3/0 AND 1 #6 E.G. ALUMINUM COND. IN 2-1/2" C
100	(FEEDER - 100 AMPS) 4 #1 AND 1 #6 E.G. COPPER COND. IN 2" C	(FEEDER - 100 AMPS) 4 #2/0 AND 1 #6 E.G. ALUMINUM COND. IN 2-1/2" C

- RISER GENERAL NOTES:**
- ELECTRICAL CONTRACTOR TO VERIFY EXISTING CONDITIONS AND TO REPORT TO GENERAL CONTRACTOR, OWNER AND ENGINEER ANY DISCREPANCY FROM THAT SHOWN ON DRAWINGS.
 - ELECTRICAL CONTRACTOR SHALL REQUEST THE DRAWINGS OF ALL OTHER DISCIPLINES APPLICABLE TO THIS SCOPE OF WORK AND CAREFULLY REVIEW ALL DRAWINGS BEFORE WORK COMMENCEMENT OR BID SUBMITTAL. IS THE RESPONSIBILITY OF THE ELECTRICAL CONTRACTOR TO PROVIDE ANY ADDITIONAL DEVICE REQUIRED FOR A COMPLETE AND FULLY FUNCTIONAL WORK OF SCOPE THAT IS NOT COVERED ON THESE DRAWINGS. COORDINATE ALL NEW ELECTRICAL WORK WITH CONTRACTORS OF ALL TRADES AND OWNER.
 - PANELS ARE REQUIRED TO HAVE AN PANELBOARD NAMEPLATE PER NEC 408.4(B) SEE TYPICAL PANELBOARD NAMEPLATE DETAILS, ELECTRICAL DETAILS SHEET FOR MORE INFORMATION
 - FOR SPECIFIC EQUIPMENT LOCATION, REFER TO ARCHITECTURAL DRAWINGS
 - ALL ELECTRICAL RUNS SHALL BE NO LESS THAN AWG #12 COPPER CONDUCTORS, UNLESS OTHERWISE NOTED.
 - AN EQUIPMENT GROUNDING CONDUCTOR SHALL BE INSTALLED IN ALL ELECTRICAL RACEWAYS AND SHALL BE SIZED IN ACCORDANCE WITH ARTICLE 250-122 OF THE NATIONAL ELECTRICAL CODE.
 - ALL PANELS SHALL HAVE AN AIC AND SCOR OF 22,000 AMPS MINIMUM, UNLESS OTHERWISE NOTED

UTILITY CONTACT INFORMATION

FOR TRANSFORMER COORDINATION INQUIRIES,
CONTACT JARED A. BUTTS E & TOR- ENGINEER I
CONTACT: 727.562.3814 (OFF), 727.401.7878
EMAIL: JARED.BUTTS@DUKE-ENERGY.COM

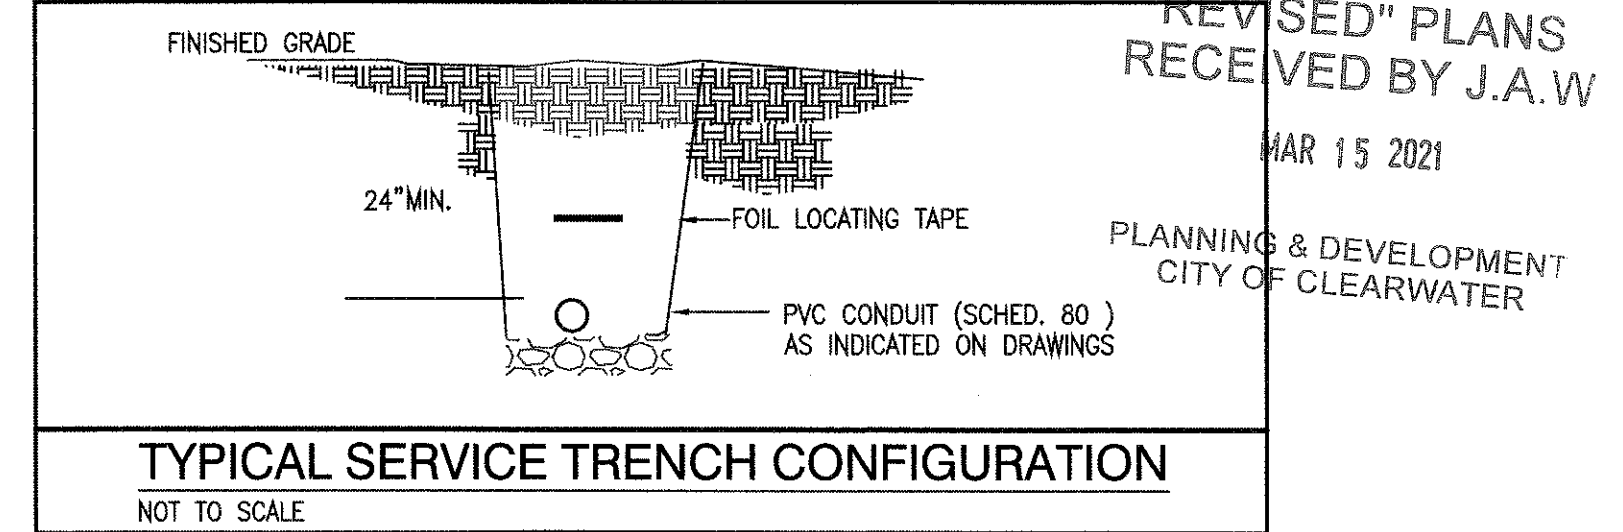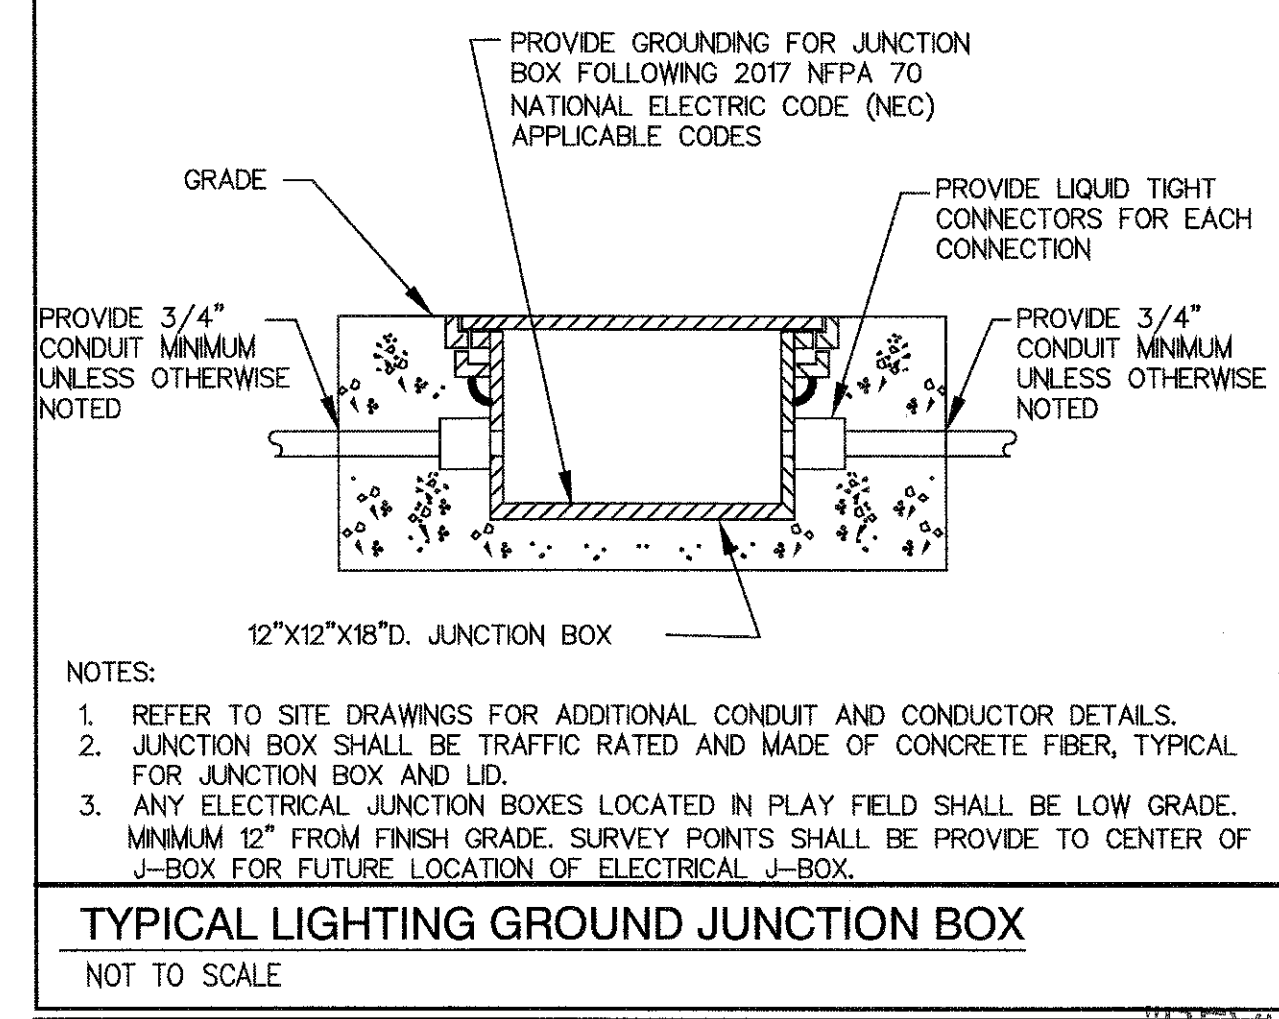


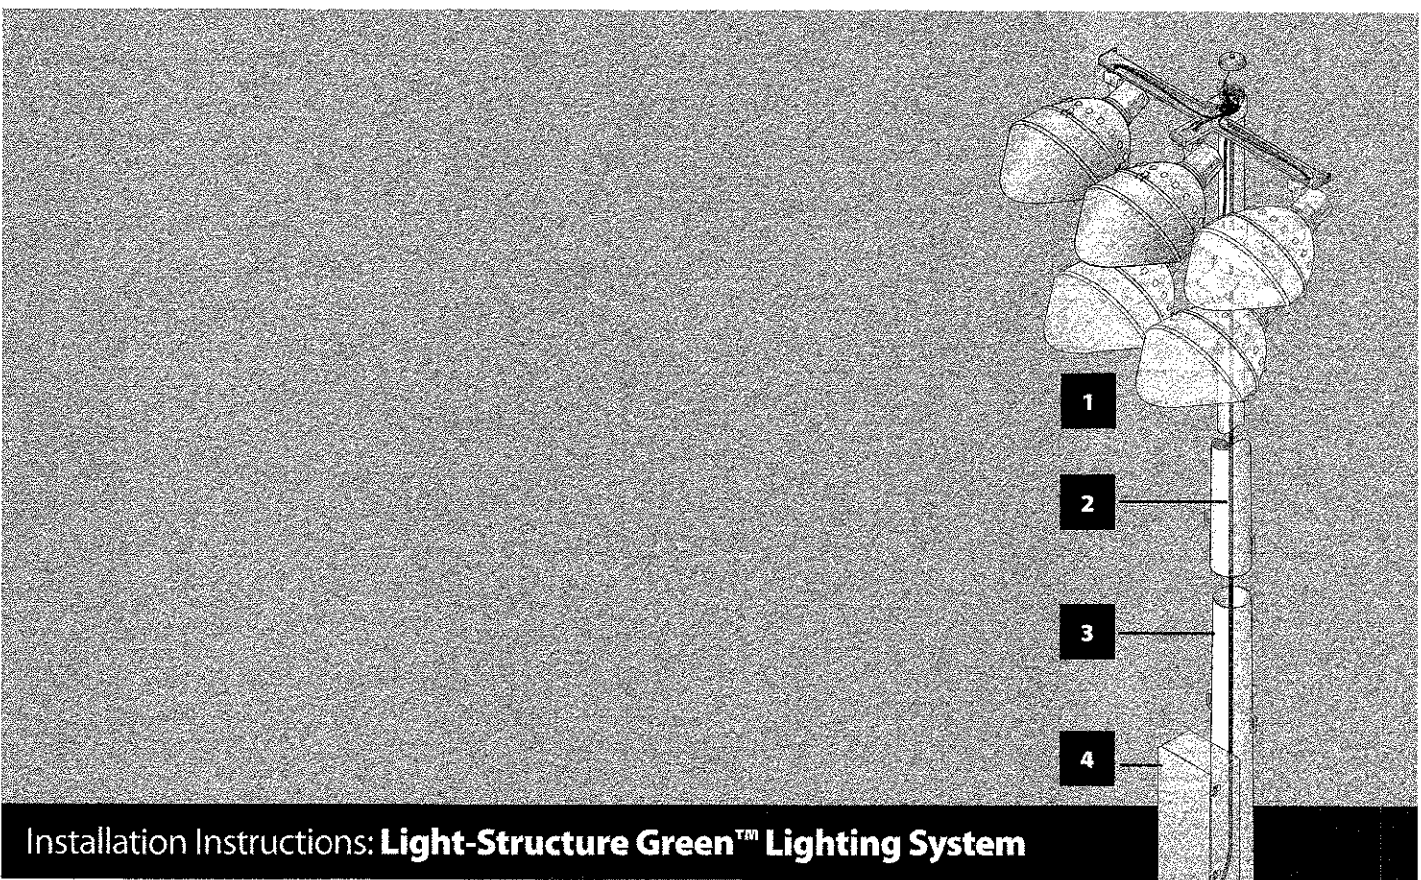

Installation Instructions: **Light-Structure Green™** Lighting System

Fast, trouble-free installation with 5 Easy Pieces™ approach to system design

- 1 **Poletop Luminaire Assembly**
- 2 **Wire Harness**
- 3 **Galvanized Steel Pole**
- 4 **Electrical Components Enclosure**
- 5 **Precast Concrete Base**

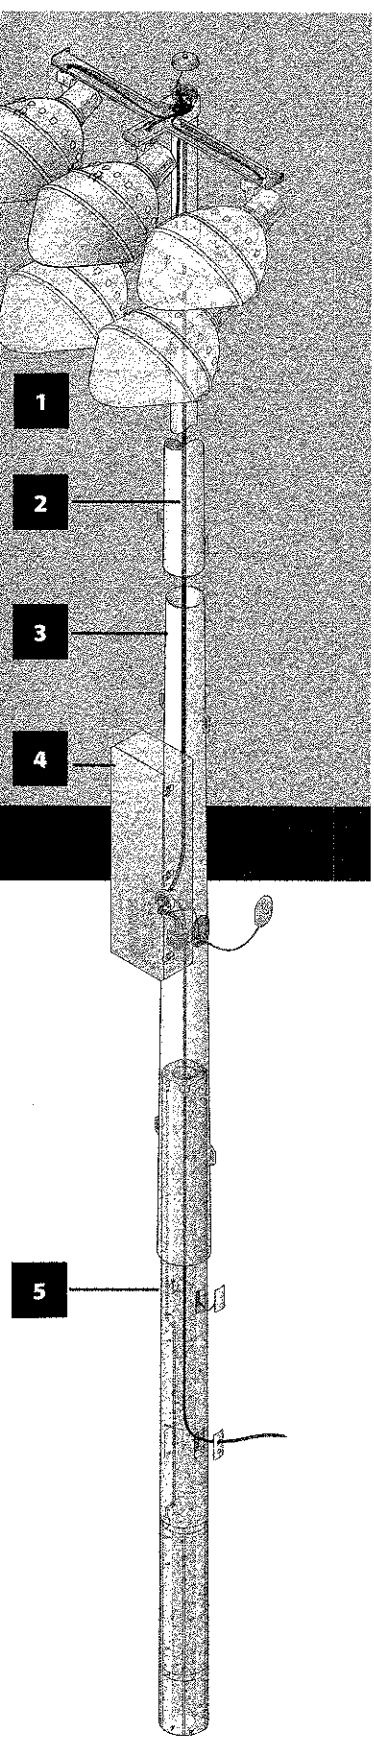

©1991, 2012 Musco Sports Lighting, LLC - M-1001-ent05-14
www.musco.com • lighting@musco.com

Installation Instructions: **Light-Structure Green™** Lighting System

Before You Begin

Standard Tools/Supplies Checklist

Refer to any supplemental instructions provided for additional tools required.

Contractor/installer supplied tools	Function	Page
Hammer, pry bar, handcutters	Unloading equipment	7
Water pump	Removing water from base holes (as needed)	9
Two 1½ ton chain-type come-alongs	Jacking pole sections together	11, 21
Large Phillips-head screwdriver	Tightening captive screws to seal enclosure to pole hub	14
Standard screwdriver	Tightening distribution lugs, 45 A disconnect switch	22, 23
Electrical fish tape, electrician's tape	Feeding wire harness through pole	15
Spray paint, chalk, or flags	Marking points to sight in aiming	17
Chalk or pencil	Making alignment marks	21
10 ft (3m) stepladder or small line truck	Connecting supply wires to electrical enclosure	22, 23
Musco supplied tools	Function	Page
Wooden base wedges	Setting base	9
Level with shim for base taper	Plumbing base	9
Steel bar	Setting base, seating pole on base	9, 21
¾ inch hex key	Attaching handhole covers on base and steel pole	8, 15, 23
¾ inch wrench	Tightening adjuster set screws, pole tip fastener, and electrical components enclosure, hanger bolt	12, 14, 15
Dishwashing liquid (original Dawn® brand)	Lubricating pole slip-fit connections	11, 17
Wooden shipping blocks	Elevating pole sections off ground during assembly	11
¾ inch ratcheting combination wrench	Tightening captive bolts to secure luminaire assembly	16
Pole rotator kit	Guiding pole onto base, pole alignment	17, 19, 20
Steel chain	Setting pole on base	21
3 mm hex key	Landing primary feed wires on 125 A disconnect switch	23
¾ inch hex key	Attaching grounding conductors inside electrical enclosure	22, 23
¾ inch hex key	Attaching braiding conductors inside pole at handhole	23
Machinery needed	Function	Page
Crane or forklift with nylon strapping and 8 ft (2.5 m) sling (sized to weight of base)	Unloading materials, setting base	7, 9
Auger	Boring holes for bases	8
Load-rated crane, nylon slings, and shackles	Setting poles	18, 19, 20

Documents You Need


- ☐ Musco Foundation and Pole Assembly Drawing
- ☐ Field Aiming Diagram
- ☐ Alternate foundation design (optional, as needed)
- ☐ Control System Summary

If you do not have all of these documents, contact Musco at +1-800-825-6020 or call your local representative.



©1991, 2012 Musco Sports Lighting, LLC - M-1001-ent05-14
www.musco.com • lighting@musco.com

INFORMATION ON THIS SHEET PROVIDED BY MUSCO LIGHTING.
SHOWN FOR REFERENCE ONLY

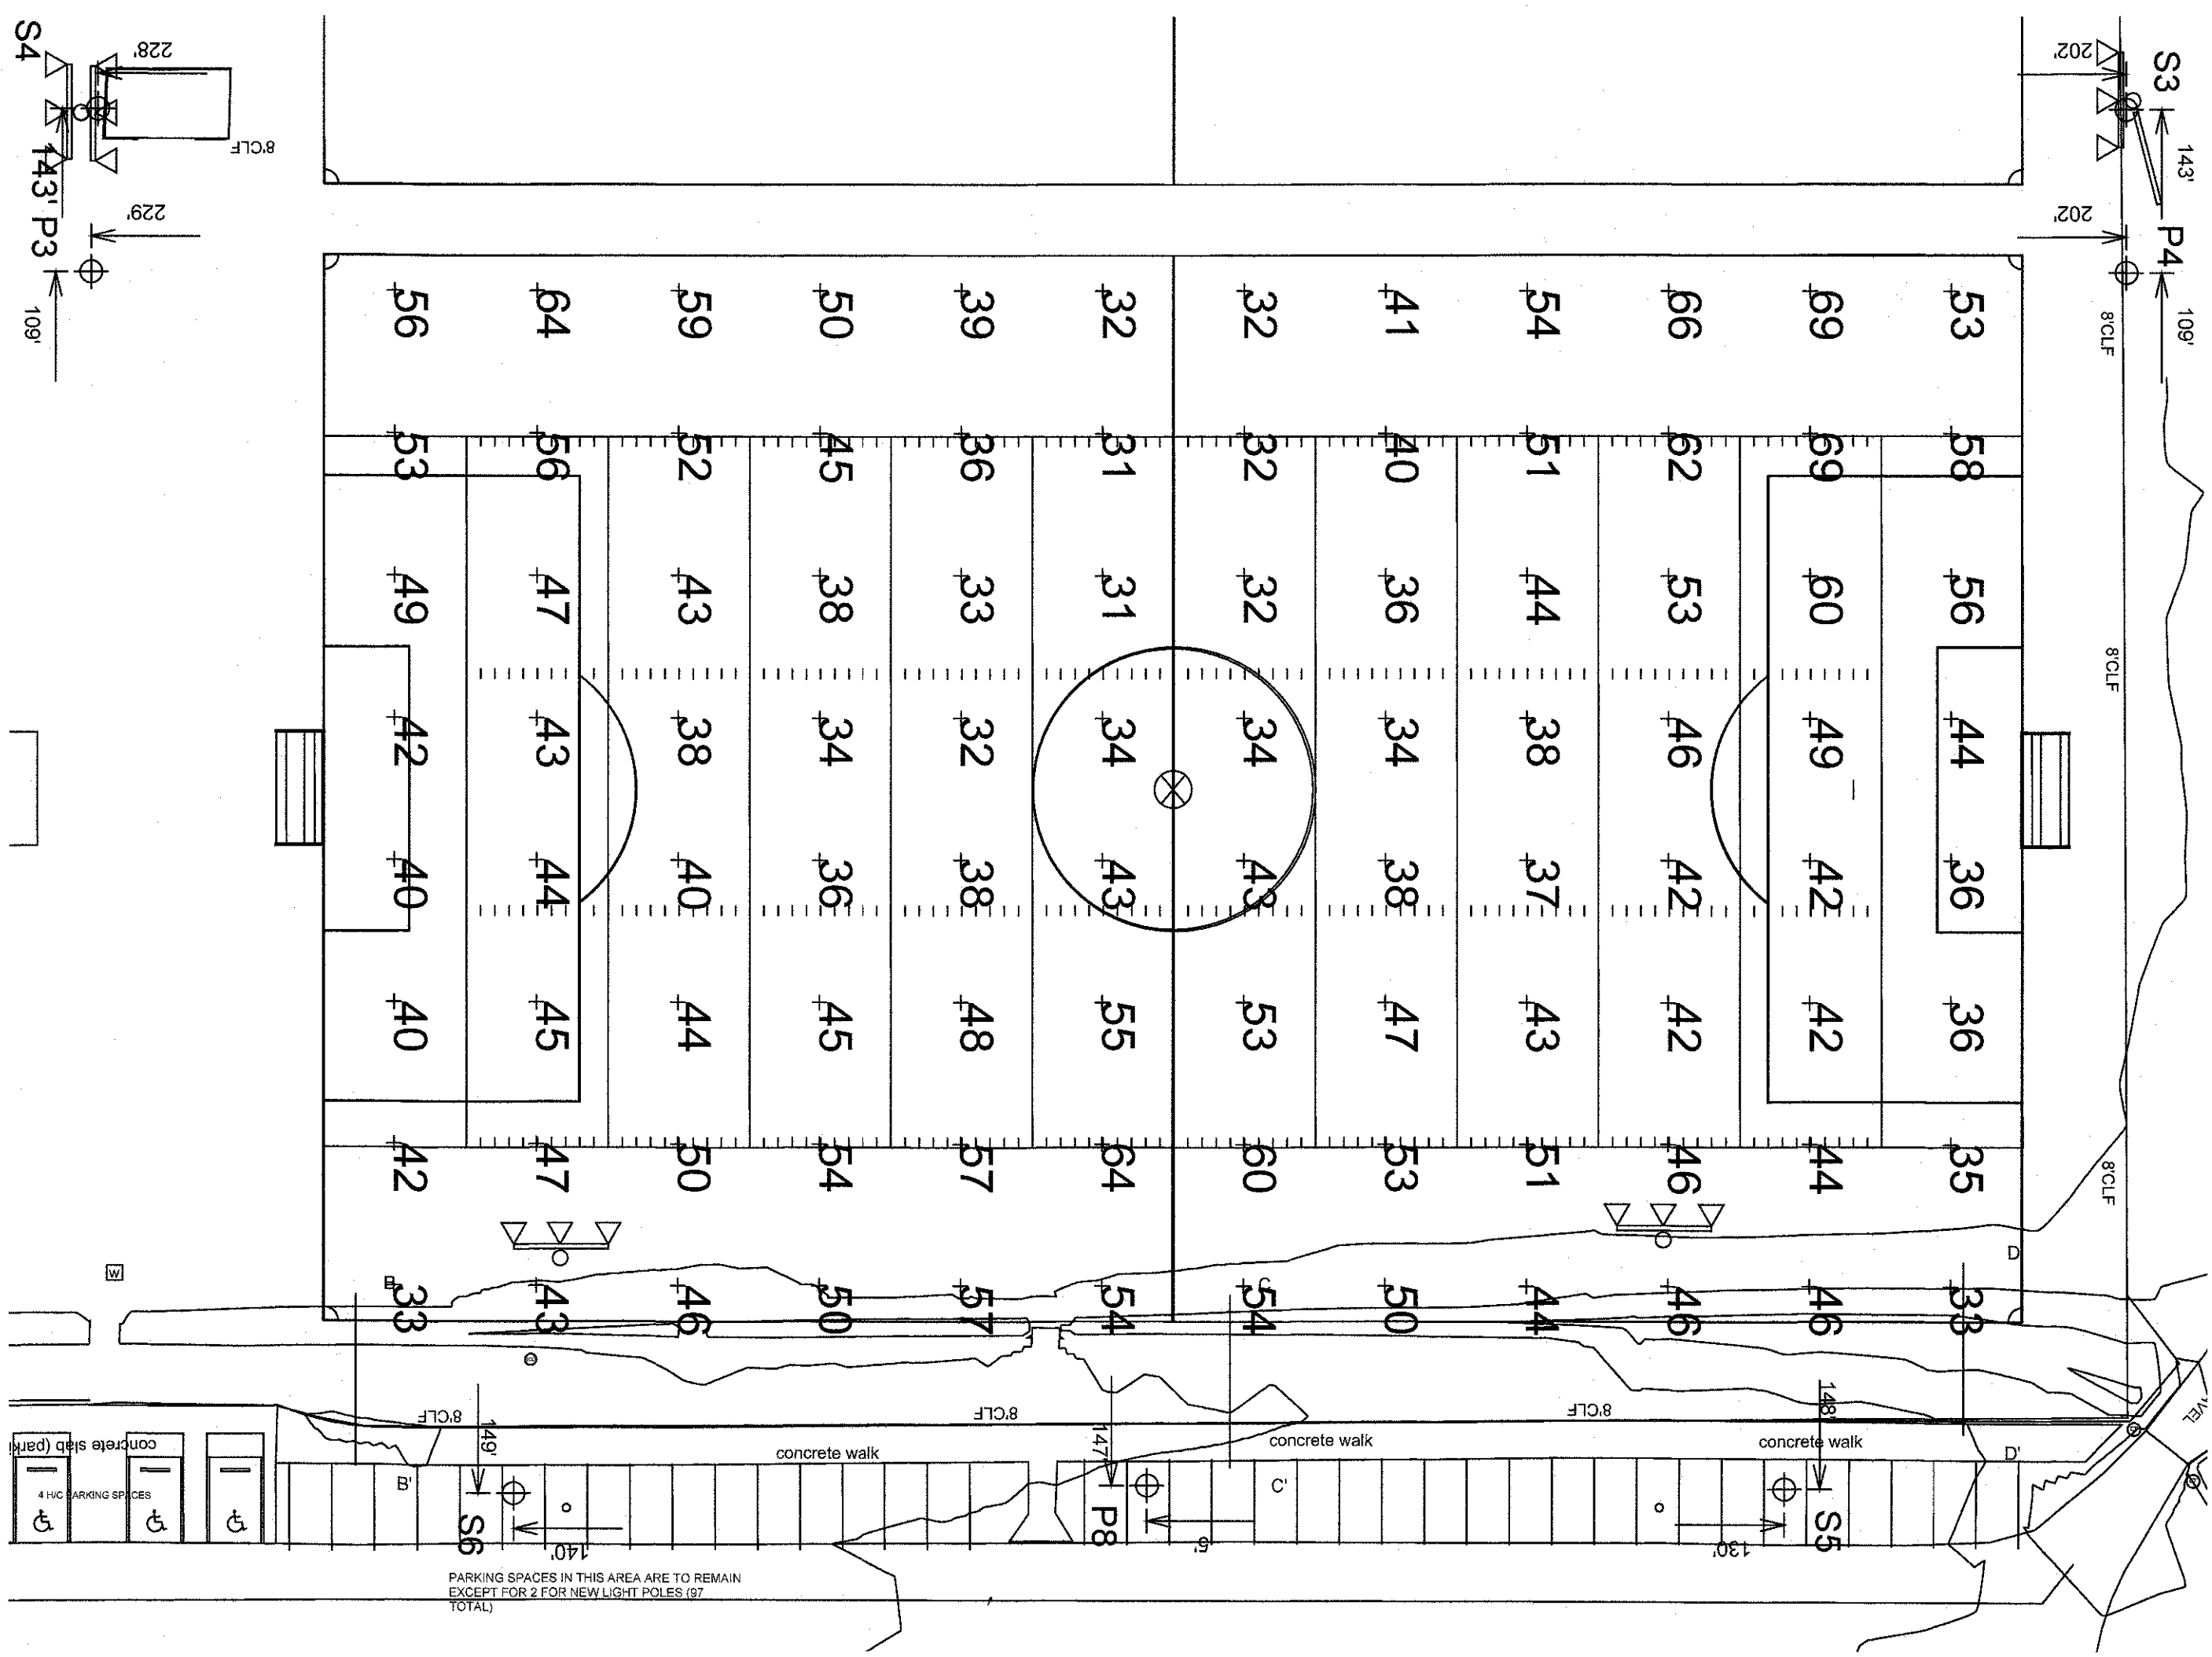

PROPOSED PHOTOMETRIC SITE PLAN

SCALE: 1/32" = 1'-0"

MY PROJECT	
Name:	Countryside Athletic Complex Redesign
Location:	Clearwater, FL
GRID SUMMARY	
Name:	Soccer 2
Size:	360.0' x 225.0'
Spacing:	30.0' x 30.0'
Height:	3.0' above grade
CONSTANT ILLUMINATION SUMMARY	
HORIZONTAL FOOTCANDLES	
Entire Grid	
Scan Average:	45.5
Maximum:	69
Guaranteed Minimum:	39
Minimum:	31
Avg / Min:	1.49
Guaranteed Max / Min:	2.5
Max / Min:	2.24
UG (adjacent path):	1.39
CU:	0.35
CV:	0.21
Application Efficacy:	29.6
No. of Points:	96
LUMINAIRE INFORMATION	
Luminaire Type:	Green Generation
Design Usage Hours:	5,000 hours
Design Lumens:	134,000
Avg Lamp Tilt Factor:	1.000
No. of Luminaires:	85
Avg KW:	132.94 (144.5 max)

Guaranteed Performance: The Guaranteed Average CONSTANT ILLUMINATION described above is guaranteed for the design usage hours of the system.

Field Measurements: Illumination measured in accordance with IESNA RP-6-15 and CIBSE LG4. Individual values may vary. See the Warranty document for details.

Electrical System Requirements: Refer to Amperage Draw Chart and/or the "Musco Control System Summary" for electrical sizing.

Installation Requirements: Results assume +/- 3% nominal voltage at line side of the ballast and structures located within 3 feet (1m) of design locations.

Installation Instructions: **Light-Structure Green™** Lighting System

Before You Begin

Electrical System Requirements

While the majority of the Light-Structure Green lighting system can be assembled by non-professionals, a qualified electrician must handle the electrical supply installation and hook-up in accordance with national, state, and local codes. Your electrician should review this information before installation begins.

The electrician is generally required to provide these items:

- Service entrance
- Main power disconnect and distribution panel(s)
- Supply wiring and equipment grounding conductors

Ensure supply wiring is rated for 90 °C. Review the label inside the electrical components enclosure door and *Control System Summary* for voltage and phase requirements.

Always dispose of lamps and other electronic waste in accordance with all applicable laws and regulations.

Other features that may affect the wiring supply requirements for this project include:

- Lighting contactor cabinets — refer to the supplemental installation instructions and the *Musco Control System Summary*.
- Control-Link® system — refer to the supplemental installation instructions and *Musco Control System Summary*.
- Auxiliary bracket option — customer supplies all wiring for auxiliary components.
- Momentary Power Interruption (MPI) luminaire — refer to the supplemental installation instructions

Volunteer Installation


Have a qualified electrician review and complete the following:

- Create electrical system design — prior to installation.
- Provide and install trenching, supply wiring, and conduit.
- Complete all steps from *Connecting to Supply Wiring* section.
- Test complete lighting system.


Components Matching and Labeling

Pole locations are identified by a pole ID (A1, A2, B1, B2, etc.) on the *Field Aiming Diagram*. These IDs are also marked on the individual components:

- Poletop luminaire assemblies and luminaire shipping cartons
- Wire harnesses
- Electrical components enclosures
- Galvanized steel pole sections
- Precast concrete bases

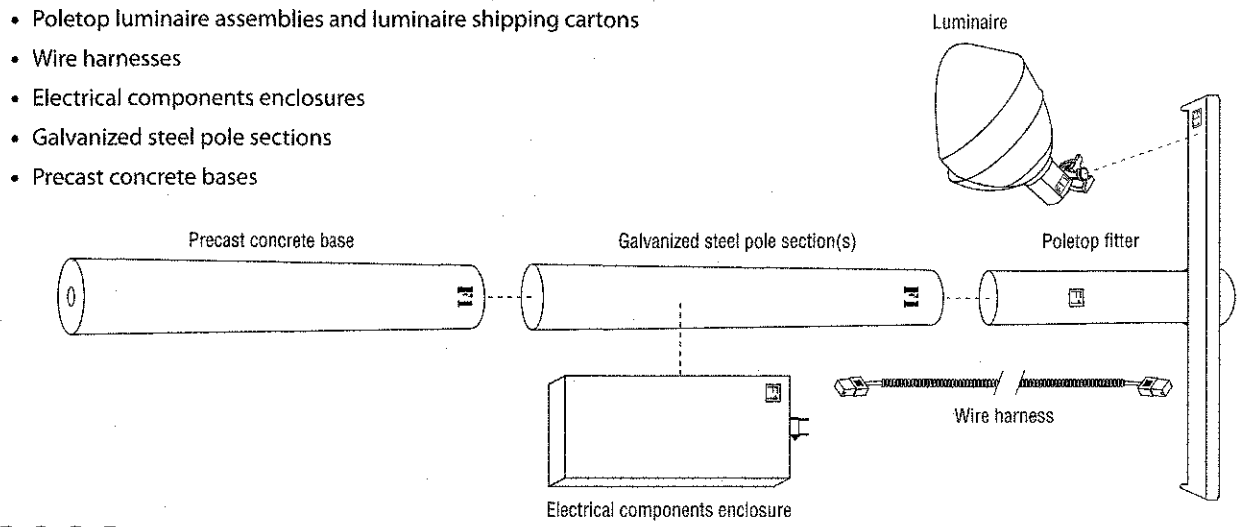

©1991, 2012 Musco Sports Lighting, LLC - M-1001-ent05-14
www.musco.com • lighting@musco.com

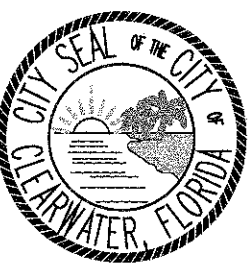

CITY OF CLEARWATER, FLORIDA
PARKS & RECREATION DEPT.
100 S. Myrtle Ave.
Clearwater, FL 33756







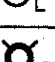
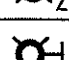
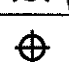









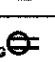
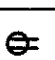




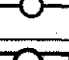







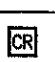
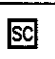

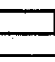


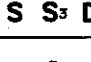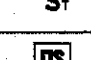

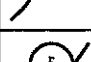
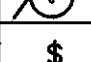

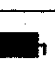





GRINER ENGINEERING, INC.
1628 First Avenue North
St. Petersburg, Florida 33713
Phone: (727)-822-2335
Fax: (727)-821-3361
Certificate of Authorization #3173

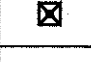Date	12/04/20
Drawn	SK
Designed	JAR
EOR	JAR
Job no.	20182

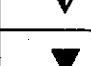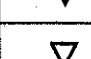
**COUNTRYSIDE SPORTS COMPLEX
FIELD 2 RENOVATION**

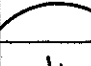DRAWN BY	SK/JAR	DES./PLANNED BY	JAR	CHECKED BY	JAR	CLEARWATER CONTRACT NO.	
SCALE	VERT. NONE	SURVEYED BY	Clearwater	BOOK NO.		CLEARWATER JOB NO.	
HORIZ.	1"=N/A	DATE DRAWN	Dec 04, 2020	DWG NAME	2020-XXXX	SHEET NO.	6
JOSE A ROSARIO, P.E. 74457						DATE	

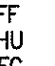ELECTRICAL SYMBOL LEGEND			
SYMBOL	DESCRIPTION	MOUNTING	
	2 X 2 FLUORESCENT FIXTURE LETTER INDICATES TYPE	SEE FIXTURE SCHEDULE	
	2 X 4 FLUORESCENT FIXTURE LETTER INDICATES TYPE	SEE FIXTURE SCHEDULE	
	SHADING DENOTES FIXTURE WITH EM BATTERY PACK. "NL" DENOTES FIXTURE UN-SWITCHED FOR NIGHT LIGHT	SEE FIXTURE SCHEDULE	
	2 X 4 FLUORESCENT FIXTURE (LETTER INDICATES TYPE) SHADING DENOTES FIXTURE FED FROM EMERGENCY SUPPLY	SEE FIXTURE SCHEDULE	
	FLUORESCENT STRIP FIXTURE LETTER INDICATES TYPE	SEE FIXTURE SCHEDULE	
	FLUORESCENT WALL BRACKET FIXTURE LETTER INDICATES TYPE	SEE FIXTURE SCHEDULE	
	RECESSED DOWNLIGHT LETTER INDICATES TYPE	SEE FIXTURE SCHEDULE	
	EXTERIOR DOWNLIGHT FIXTURE LETTER INDICATES TYPE	SEE FIXTURE SCHEDULE	
	EXTERIOR WALL MOUNTED FIXTURE LETTER INDICATES TYPE	SEE FIXTURE SCHEDULE	
	INTERIOR PENDANT FIXTURE LETTER INDICATES TYPE	SEE FIXTURE SCHEDULE	
	EXTERIOR SURFACE MOUNT FIXTURE LETTER INDICATES TYPE	SEE FIXTURE SCHEDULE	
	WALL LOW MOUNTED FIXTURE	SEE FIXTURE SCHEDULE	
	CEILING FAN	SEE FIXTURE SCHEDULE	
	EXIT-SHADING DENOTES FACEPLATE LOCATION, LETTER INDICATES TYPE, PROVIDE ARROWS AS REQUIRED.	SEE FIXTURE SCHEDULE	
	DENOTES EMERGENCY WALL PACK, LETTER INDICATES TYPE.	SEE FIXTURE SCHEDULE	
	DENOTES TRACK LIGHTING, LETTER INDICATES TYPE.	SEE FIXTURE SCHEDULE	
	SINGLE POLE SWITCH (20A-120/277) '3' DENOTES 3-WAY, 'D' DENOTES DIMMER	48" AFF OR AS NOTED	
	'T' DENOTES TOGGLE SWITCH	ABOVE CEILING	
	OCCUPANCY SENSOR	48" AFF OR AS NOTED	
	LOW VOLTAGE LIGHTING SWITCH	48" AFF OR AS NOTED	
	DUPLEX RECEPTACLE, 125V, 20A 'IG' DENOTES ISOLATED GROUND	18" AFF OR AS NOTED	
	DUPLEX RECEPTACLE, 125V, 20A	18" AFF OR AS NOTED	
	DUPLEX RECEPTACLE, 125V, 20A	48" AFF OR AS NOTED	
	QUAD RECEPTACLE, 125V, 20A	18" AFF OR AS NOTED	
	SINGLE RECEPTACLE, 208V OR 240V	18" AFF OR AS NOTED	
	CEILING MOUNTED COILED REEL EXTENSION RECEPTACLE.	CEILING MOUNTED	
	CEILING/WALL MOUNTED BOX WITH 20A DUPLEX RECEPTACLE AND DATA OUTLET.	SEE DETAIL OR AS NOTED	
	JUNCTION BOX	SEE DETAIL OR AS NOTED	
	POWER/TELEPHONE POLE	SEE DETAIL OR AS NOTED	
	OUTLET BOX OR J-BOX FOR POWER AND DATA SUPPLY TO FURNITURE SYSTEMS	18" AFF OR AS NOTED	
	FLOOR BOX WITH 20A DUPLEX RECEPTACLE AND DATA OUTLET.	SEE DETAIL OR AS NOTED	
	COMBINATION VOICE/DATA OUTLET	18" AFF OR AS NOTED	
	DATA OUTLET	18" AFF OR AS NOTED	
	VOICE OUTLET	18" AFF OR AS NOTED	
	FAX OUTLET	18" AFF OR AS NOTED	
	CARD READER	COORDINATE WITH SECURITY INSTALLER	
	SURVEILLANCE CAMERA	COORDINATE WITH SECURITY INSTALLER	
	T.V. OUTLET	18" AFF OR AS NOTED	
	PANELBOARD 120/208V	SEE PANEL SCHEDULE	
	PANELBOARD 277/480V	SEE PANEL SCHEDULE	
	RACEWAY CONCEALED IN WALL OR ABOVE CEILING	SEE SPECIFICATIONS	
	UNDERGROUND OR UNDER FLOOR CONDUIT	SEE SPECIFICATIONS	
	HOMERUN TO PANEL, LETTERS INDICATE PANEL, NUMBERS INDICATE CIRCUIT, NOTE: HASH MARKS INDICATES THE NUMBER OF WIRES EXCLUDING THE REQUIRED EQUIPMENT GROUND.	SEE SPECIFICATIONS	
	MOTOR, NUMERAL INDICATES HORSEPOWER	AS NOTED	
	MOTOR RATED SWITCH WITH OVERLOAD RELAYS AS REQUIRED.	MOUNTED ADJACENT TO EQUIPMENT	
	NON-FUSIBLE SAFETY SWITCH-SIZE AS NOTED	SEE SPECIFICATIONS	
	FUSIBLE SAFETY SWITCH-SIZE AS NOTED	SEE SPECIFICATIONS	
*NOTE - ALL SYMBOLS SHOWN MAY NOT BE USED.			
ABBREVIATIONS:			
AFF -	ABOVE FINISHED FLOOR	HYAC -	HEATING, VENTILATING, AIR CONDITIONING
AHU -	AIR HANDLING UNIT	JB -	JUNCTION BOX
BFG -	BELOW FINISHED GRADE	LRA -	LOCKED ROTOR AMPERES
C -	CONDUIT	MCB -	MAIN CIRCUIT BREAKER
CW -	COOL WHITE	MLO -	MAIN LUGS ONLY
DACP -	DOOR ALARM CONTROL PANEL	N -	NEUTRAL
DN -	FEED DOWNWARD	NL -	NIGHT LIGHT
EF -	EXHAUST FAN	OB -	OUTLET BOX
EG -	EQUIPMENT GROUND	PB -	PULL BOX, PUSH-BUTTON
ENCL -	ENCLOSURE	PS -	PAY STATION
EW -	ELECTRIC WATER COOLER	SP -	SUPPLY FAN
EWH -	ELECTRIC WATER HEATER	SPEC -	SPECIFICATIONS
WX -	EXPLOSION PROOF	TL -	TWISTLOCK
FCU -	FAN COIL UNIT	TB -	TELEPHONE TERMINAL BOARD
FHP -	FRACTIONAL HORSEPOWER	TVB -	TELEVISION TERMINAL BOARD
FLA -	FULL LOAD AMPERES	UNO -	UNLESS NOTED OTHERWISE
G -	GROUND	UP -	FEED UPWARD
GFI -	GROUND FAULT INTERRUPTER	VERT -	VERTICAL
HID -	HIGH INTENSITY DISCHARGE	WM -	WATT METER
HORIZ -	HORIZONTAL	WP -	WEATHERPROOF
IG -	ISOLATED GROUND	WW -	WARM WHITE
LW -	LIGHT WHITE	XFR -	TRANSFORMER
HP -	HORSEPOWER, HEAT PUMP	N.L.C. -	NOT IN CONTRACT
NOTE:			
1. ALL MOUNTING HEIGHTS SHOWN ARE TO THE TOP OF THE DEVICE UNLESS NOTED OTHERWISE.			
2. NOT ALL SYMBOLS APPEAR ON PLANS.			

ELECTRICAL GENERAL NOTES:	
1. ALL WORK SHALL CONFORM TO THE REQUIREMENTS OF THE FLORIDA BUILDING CODE 2017 - NATIONAL ELECTRIC CODE 2014, NFPA 70, NFPA 101 & NFPA 72 (CURRENT ADOPTED EDITIONS), ANY OTHER APPLICABLE CODE REFERENCES AND ALL LOCAL ORDINANCES.	
2. BIDDERS ARE TO VISIT THE SITE AND FAMILIARIZE THEMSELVES WITH EXISTING CONDITIONS AND SATISFY THEMSELVES AS TO THE NATURE AND SCOPE OF WORK AND THE EXTENT OF DEMOLITION. THE SUBMISSION OF A BID WILL BE EVIDENCED THAT SUCH AN EXAMINATION HAS BEEN MADE. LATER CLAIMS FOR LABOR, EQUIPMENT OR MATERIALS REQUIRED, OR FOR DIFFICULTIES ENCOUNTERED WHICH COULD HAVE BEEN FORESEEN HAD AN EXAMINATION BEEN MADE, WILL NOT BE ALLOWED.	
3. ELECTRICAL CONTRACTOR SHALL BE EXPERIENCED IN PERFORMING AND INSTALLATION OF WORK SIMILAR TO THAT REQUIRED FOR THIS PROJECT. THE CONTRACTOR SHALL SUBMIT A LIST OF AT LEAST FIVE PROJECTS THAT THEY HAVE CONTRACTED AND COMPLETED CONSTRUCTION WITH SIMILAR PROJECT SCOPE OF WORK.	
4. PRIOR TO SUBMITTING A BID, THE CONTRACTOR SHALL HAVE STUDIED AND COMPARED THE CONTRACT DOCUMENTS WITH EXISTING/PROPOSED CONDITIONS AND NOT LATER THAN TEN (10) DAYS PRIOR TO THE BID OPENING SHALL REPORT TO THE ENGINEER ANY ERROR, INCONSISTENCY, OR OMISSION IN THE CONTRACT DOCUMENTS.	
5. ELECTRICAL EQUIPMENT SHALL BE AS SPECIFIED. ARCHITECT AND ENGINEER WILL REVIEW ANY SUBSTITUTION FOR COMPATIBILITY.	
6. ALL CUTTING, REMOVING AND REPLACING CONCRETE WORK SHALL BE THE RESPONSIBILITY OF THE TRADE INVOLVED, COORDINATE WITH SITE CONTRACTOR	
7. PROTECT ELECTRICAL EQUIPMENT AND INSTALLATIONS AS NECESSARY. IF DAMAGED OR DISTURBED IN THE COURSE OF THE WORK, REMOVE DAMAGED PORTIONS AND NOT LATER THAN TEN (10) DAYS PRIOR TO THE BID OPENING SHALL REPORT TO THE ENGINEER ANY ERROR, INCONSISTENCY, OR OMISSION IN THE CONTRACT DOCUMENTS.	
8. THE CONTRACTOR SHALL INCLUDE WITHIN THE BID ALL REQUIRED OFF HOUR, OVERTIME, AND NON-BUSINESS HOUR WORK AS REQUIRED.	
9. ALL WORK SHALL BE COORDINATED WITH OTHER TRADES FOR ITEMS IN THEIR SCOPE OF WORK WHICH WOULD REQUIRE ELECTRICAL WORK (DISCONNECTION/RECONNECTION ETC.) AND ARE NOT INDICATED ON THE ELECTRICAL PLANS. ALL SUBCONTRACTORS ARE REQUIRED TO COORDINATE THEIR WORK WITH OTHER TRADES. LACK OF THIS COORDINATION RESULTING IN ADDED COST TO THE CONTRACT WILL BE BORNE BY THE SUBCONTRACTOR.	
10. THE CONTRACTOR SHALL PROVIDE SHOP DRAWINGS AND SUBMITTALS FOR ELECTRICAL EQUIPMENT SHOWN ON THE PLANS AND SPECIFICATIONS FOR THE ENGINEER'S APPROVAL. THE ENGINEER MAY REQUIRE THE CONTRACTOR TO REDO ANY WORK, WHICH WAS NOT APPROVED, OR THE ENGINEER MAY REQUIRE A CREDIT TO THE OWNER. PROVIDE A SET OF AS-BUILT AFTER THE JOB IS COMPLETED. THIS SET SHALL BE CONTINUOUSLY UPDATED DURING CONSTRUCTION.	
11. PROVIDE IDENTIFICATION FOR ALL LIGHT FIXTURES AND ALL ELECTRICAL COVER PLATES WITH PERMANENT MARKER ON A SELF-ADHERING TAG INDICATING PANEL AND CIRCUIT NUMBER, TYPICAL FOR ALL LIGHTING AND POWER DEVICES.	
12. ALL WORK SHALL BE PERFORMED DURING TIME PERIODS ACCEPTABLE TO THE OWNER. SCHEDULE ALL WORK WITH THE OWNER'S REPRESENTATIVE BEFORE PROCEEDING.	
13. THE CONTRACTOR SHALL PERFORM ALL TEMPORARY WORK NECESSARY TO MAINTAIN CONTINUITY OF ELECTRICAL SERVICE (LIKE SAWPOLE SERVICE) WHEN CONNECTION IS MADE. THIS SERVICE SHALL NOT BE INTERRUPTED WITHOUT PRIOR CONSENT OF THE OWNER'S REPRESENTATIVE AND MAY BE INTERRUPTED ONLY AT AND FOR THE SPECIFIED TIME DESIGNATED BY OWNER'S REPRESENTATIVE. THE CONTRACTOR SHALL BE GUIDED BY THE OWNER'S REPRESENTATIVE AT ALL TIMES IN MATTERS AFFECTING THE FACILITIES.	
14. THE CONTRACTOR SHALL COORDINATE ALL PHASING OF ELECTRICAL WORK AS REQUIRED AND INDICATED ON THE ELECTRICAL DRAWINGS.	
15. THE OWNER PROJECT REPRESENTATIVE SHALL BE NOTIFIED PRIOR TO CUTTING OF ANY STRUCTURAL ITEM (I.E. CONCRETE FLOOR, MASONRY, WALL, ETC.) WITHIN THE EXISTING BUILDING. METHOD OF CUTTING SHALL BE APPROVED BY THE OWNER PROJECT REPRESENTATIVE.	
16. CONTRACTOR SHALL BE RESPONSIBLE FOR KEEPING THE BUILDING WATERTIGHT DURING CONSTRUCTION.	
17. ALL WIRING IN CEILING SPACE OR IN AIR HANDLING PLENUMS NOT IN CONDUIT SHALL BE UL LISTED AS SUITABLE FOR PLENUM USE.	
18. ALL JUNCTION BOXES AND COVER PLATES SHALL BE PAINTED AND LABELED.	
19. ALL RECEPTABLES WITHIN (6) FEET OF PLUMBING FIXTURES SHALL BE PROVIDED WITH 5 MILLAMP GROUND FAULT INTERRUPTERS, (GFCI RECEPTABLES)	
20. EXIT SIGNS AND EMERGENCY LIGHTING SHALL BE WIRE MESH OF ANY SWITCHING OR CONTACTORS. DO NOT SWITCH EXIT SIGNS OR EMERGENCY LIGHTS. CONTRACTOR SHALL BE RESPONSIBLE FOR PROVIDING IT TO BYPASS ANY SWITCHING AND/OR CONTACTORS FOR ALL SWITCHED EMERGENCY LIGHTING.	
21. EDGE OF LIGHT SWITCH WALL PLATE SHALL BE NOT MORE THAN 1" AWAY FROM METAL/WOOD DOOR FRAME. TYPICAL FOR SINGLE OR MULTIPLE WALL SWITCHES.	
22. CONFIRM MOUNTING HEIGHTS AND COORDINATE LOCATION OF ALL OUTLETS, SWITCHES, AND OTHER DEVICES WITH ARCHITECTURAL ELEVATIONS (FURNITURE LAYOUT) PRIOR TO ROUGH-IN.	
23. PROVIDE SEAL FOR PENETRATION OF FIRE RATED WALLS BY CONDUIT.	
24. BACK TO BACK RECEPTABLES IN ALL ONE HOUR FIRE RATED WALLS SHALL BE LOCATED A MINIMUM OF 24" ON CENTER.	
25. BRANCH CIRCUIT CONDUCTORS SHALL NOT BE SMALLER THAN NO. 12 AND WHERE BRANCH CIRCUIT CONDUCTOR RUNS FROM SOURCE (PANEL) TO THE LAST DEVICE ON THE CIRCUIT EXCEEDS 75 FT. IN LENGTH, THE CONDUCTORS SHALL BE NO. 10 MINIMUM AND FOR THE ENTIRE LENGTH OF THE CIRCUIT. FOR RUNS OVER 150 FT. IN LENGTH THE CONDUCTOR SHALL BE NO. 8 MINIMUM AND FOR THE ENTIRE LENGTH OF THE CIRCUIT. THE ABOVE APPLIES TO 120 VOLT CIRCUITS ONLY.	
26. THE CONTRACTOR SHALL COORDINATE WITH THE OWNER THE REMOVAL AND DISPOSAL OF ALL ELECTRICAL MATERIAL WHICH IS NOT TO BE USED ON THE PROJECT. CONTRACTOR SHALL REMOVE AND STORE ANY ELECTRICAL MATERIAL IF SO DIRECTED BY OWNER. PATCH AND PAINT WALLS AND CEILINGS AS REQUIRED. THE CONTRACTOR SHALL COORDINATE INSTALLATION OF NEW LIGHTING FIXTURES, RECEPTABLES, PANEL BOARDS, ETC. WITH EXISTING STRUCTURE, PIPING, ETC. AND MAKE ADJUSTMENTS AS REQUIRED.	
27. REFER TO ELECTRICAL SPECIFICATIONS SHEET FOR REQUIREMENTS.	
28. UPON COMPLETION OF THE WORK, THE CONTRACTOR SHALL INSURE THAT ALL SYSTEMS OPERATE AS DESIGNED AND REQUIRED AND SHALL REVIEW THEIR OPERATION WITH THE OWNER AND PROVIDE TRAINING OF THE MAINTENANCE PERSONNEL. COMPLETE SET OF AS-BUILT DRAWINGS SHALL BE COMPILED (BY THE CONTRACTOR) AND ISSUED (1 EACH) TO THE ARCHITECT AND BUILDING MAINTENANCE PERSONNEL UPON COMPLETION OF CONSTRUCTION AND TESTING.	
29. ALL FEEDERS SIZING (BRANCH AND SERVICE ENTRANCE CONDUCTORS) BASED IN AMPACITY OF COPPER THW CONDUCTORS (NEC 2011 TABLE 310.15(B)(16)) UNLESS OTHERWISE NOTED.	
30. THE PRIMARY POWER SOURCE FOR SMOKE ALARMS IN DWELLING UNITS SHALL BE REQUIRED TO BE AFCI-PROTECTED FOLLOWING NFPA 72 AND NEC 2011 ART. 210.12.	
31. RECEPTABLES LOCATED IN DORMITORIES AND LIVING AREAS OF ALL DWELLING UNITS SHALL BE AFCI PROTECTED.	
32. MINIMUM SERVICE INTERRUPTION OF EXISTING FIELD SHALL BE KEPT TO A MINIMUM. EXISTING TRANSFORMER SHALL REMAIN OPERATIONAL UNTIL NEW TRANSFORMER IS IN PLACE AND SWITCHOVER SHALL OCCUR WITHIN 24 HRS BETWEEN SHUT DOWN & START UP OF NEW POLE & SERVICES.	
NATIONAL ELECTRIC CODE NOTES:	
ALL WORK SHALL CONFORM TO THE REQUIREMENTS OF NFPA 70 - 2014 NATIONAL ELECTRIC CODE	
ELECTRICAL SUBMITTAL NOTES:	
SUBMIT ALL ELECTRICAL SYSTEMS SUBMITTALS AT ONE (1) TIME IN ONE (1) INTEGRAL GROUP. PIECE-BY-PIECE SUBMISSION OF INDIVIDUAL ITEMS WILL NOT BE ACCEPTABLE. ENGINEER MAY CHECK CONTENTS OF EACH SUBMITTAL SET UPON INITIAL DELIVERY. IF NOT COMPLETE AS SET FORTH HEREIN, SUBMITTAL SETS MAY BE RETURNED TO CONTRACTOR WITHOUT REVIEW AND APPROVAL AND WILL NOT BE ACCEPTED UNTIL MADE COMPLETE. SHOP DRAWINGS WILL BE REVIEWED MAXIMUM TWICE AS PART OF THIS CONTRACT. ADDITIONAL SHOP DRAWING REVIEWS SHALL BE INVOICED AT \$85.00 PER HOUR, BILLABLE TO THE SUB-CONTRACTOR.	

BILL OF MATERIALS	
CountrySide Soccer Stadium Field September 11, 2018	
TYPE OF FIELDS:	1) 360' x 225' Soccer field
DESIGN OBJECTIVE:	Re-use existing pole and fixtures and add poles & fixtures where needed to achieve a lighting design of 50c minimum.
SCOPE OF WORK:	Poles S4 & S9 Will remain. Poles S10 & S11 will be taken down. The bases will be removed. The poles will be removed. The fixtures will be removed and re-used on new S10 & S11 poles
NEW POLES:	Musco will provide 2 x 70' steel poles & bases 1 x 80' steel pole & base 1 x 80' steel pole & base Foundation Designs
FIXTURES:	Musco will be providing: 49 new fixtures to be attached to the new poles. In addition, the existing fixtures from existing poles S10 & S11 will be re-used for this design
CONTACTORS	Musco will be providing: New contactors for the additional poles.
MUSCO Lighting Budget Estimate	
COUNTRYSIDE SOCCER REDESIGN Field #5 Date: August 15, 2018	
Field Description: Based on Musco lighting design 1800388 Light Structure Green™ System delivered to your site in Five Easy Pieces™	
Also Includes: • Energy savings of more than 50% over a standard lighting system • 50% less spill and glare light than Musco's prior industry leading technology • Musco C10 Warranty and maintenance	
Scope Poles P3 & P6 will be added. Existing poles S10 & S11 will be removed New poles for S10 & S11 will be supplied The fixtures from existing poles S10 & S11 will be added to new poles S10 & S11	
MUSCO Lighting Budget Estimate	
CountrySide Soccer Stadium Field September 11, 2018	
COUNTRYSIDE SOCCER REDESIGN Soccer 2 - PB Pole (no new fixtures) Date: November 19, 2019	
Field Description: Based on Musco lighting design 1800388 Light Structure Green™ System delivered to your site in Five Easy Pieces™	
Also Includes: • Energy savings of more than 50% over a standard lighting system • 50% less spill and glare light than Musco's prior industry leading technology • Musco C10 Warranty and maintenance	
Scope Poles P3 & P6 will be added. Existing poles S10 & S11 will be removed New poles for S10 & S11 will be supplied The fixtures from existing poles S10 & S11 will be added to new poles S10 & S11	

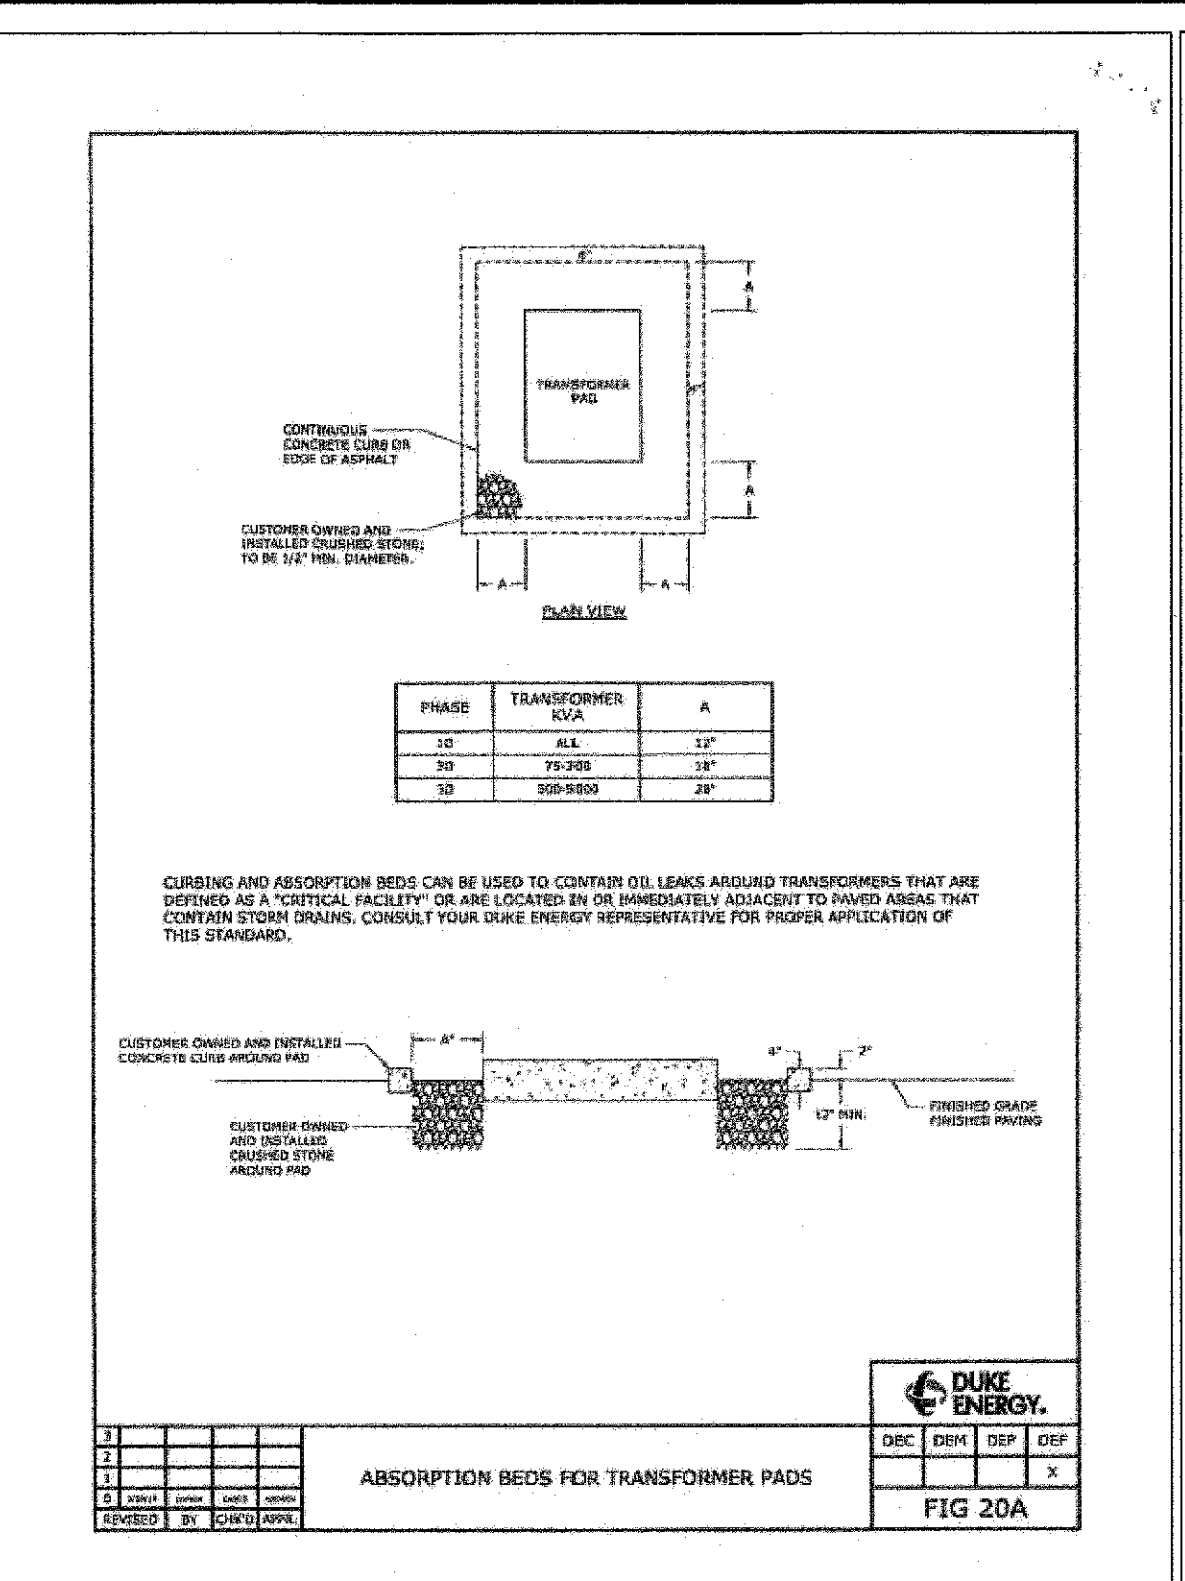

UTILITY CONTACT INFORMATION			
FOR TRANSFORMER COORDINATION INQUIRIES, CONTACT JARED A. BUTTS E & TOR- ENGINEER I CONTACT: 727.562.3814 (OFF), 727.401.7878 EMAIL: JARED.BUTTS@DUKE-ENERGY.COM			

NOTES:			
1. CUSTOMER TO PROVIDE AND INSTALL TRANSFORMER PAD PER REFERENCED DOCUMENT IN SECTION III.B.			
2. THIS GROUND SHALL BE LEVELED AND THOROUGHLY COMPACTED BEFORE THE PAD IS INSTALLED.			
3. THERE SHALL BE NO ABOVE GROUND OBSTRUCTIONS WITHIN 10 FEET OF THE FRONT OF THE TRANSFORMER ON EITHER SIDE OF THE SIDING AND BACK. IF RETENING TROUGH IS LOCATED BEHIND TRANSFORMER, MINIMUM CLEARANCE BETWEEN BACK OF TRANSFORMER AND CLOSET PART OF TROUGH IS 8 FEET.			
4. SLOPE MAY BE REQUIRED AROUND PAD TO PREVENT EROSION, AS DETERMINED BY A DUKE REPRESENTATIVE.			
5. SIDE VENTILATION MAY BE REQUIRED IF THERE IS A WALL CONSTRUCTED AROUND THE TRANSFORMER.			
6. IF THE CUSTOMER PLANS TO RUN A NUMBER OF CONDUCTORS BEYOND THE MAXIMUM ALLOWED, A JUNCTION BOX MAY BE REQUIRED FOR TERMINATION OF THE CUSTOMER'S CONDUCTORS. SEE FIGURE 19B.			
7. CONTACT A COMPANY ENGINEERING REPRESENTATIVE FOR DETERMINATION OF NEED FOR CRUSHED STONE, CURBING AND ABSORPTION BEDS. REACT ORIENTATION OF THE TRANSFORMER IN THE FIELD MUST BE APPROVED BY A COMPANY ENGINEERING REPRESENTATIVE.			
8. IN AREAS WHERE TRANSFORMERS ARE TO BE ELEVATED ABOVE NORMAL GRADE, ENGINEERING DEPARTMENT MUST BE CONTACTED FOR APPROVAL OF DESIGN.			
9. EXTEND CONDUITS 1" ABOVE TOP OF CONCRETE PAD.			
10. CONDUIT FOR DUKE ENERGY PRIMARY CABLES SHALL BE SPECIFIED BY A DUKE ENERGY REPRESENTATIVE TO BE EITHER 4", 5" OR 6" DIAMETER AND INSTALLED BY THE CUSTOMER PRIOR TO POURING/INSTALLING THE CONCRETE PAD. THERE SHALL BE TWO PRIMARY CONDUITS INSTALLED (ONE FOR EACH SET OF THREE) PRIMARY CABLES). THE CONDUIT SHALL BE A SCHEDULE 40 ELBOW WITH A 36" BEND RADIUS.			
11. INSTALL CONDUIT BED BEDS WHERE CABLES EXIT CONDUITS ON THE PRIMARY AND SECONDARY CONDUITS OF THE TRANSFORMER TO PREVENT DAMAGE TO THE CABLES DURING INSTALLATION.			
12. CUSTOMER SHALL INSTALL FIVE CONDUIT FOR THE PRIMARY CONDUCTORS AS CLOSE TO THE CENTER OF THE DESIGNATED PRIMARY SIDE OF THE WINDOW OF THE PAD AS PRACTICAL.			
13. CUSTOMER SERVICE CONDUITS SHALL NOT CROSS OR INTERFERE WITH THE PRIMARY CONDUITS. (THE SERVICE CONDUIT CAN EXIT THE SECONDARY SIDE EITHER COMING OUT THE FRONT, THE REAR SIDE, OR THE BACK.)			
14. THE SERVICE CONDUITS SHALL NOT EXTEND OUTSIDE THE DESIGNATED SECONDARY SIDE OF THE WINDOW OF THE PAD.			
DUKE ENERGY			
CONDUIT AND CONCRETE SPECIFICATIONS			
FIG 19B			

#4 REBAR
8" SPACING

PLAN VIEW

NOTES:

1. SEE FIGURE 19B FOR NOTES.

RECEIVED BY: J.A.W.

JAN 28 2021

PLANNING & DEVELOPMENT
CITY OF CLEARWATER

DEC	DEM	SEP	DEF
			X


FIG 19A

FLAT PADS FOR THREE-PHASE

PAD-MOUNTED TRANSFORMERS 75KVA - 300KVA


DATE	REVISION	BY	DATE	APPROVED

RECORD DRAWINGS																																																																																																																																																																																																																																																																																																																																																																																																																																																																																																																																																																																																																																																																																																																																																																																																																																																																																																																																																																																																																																																																																																																																																																																																																																																																																																																																																																																																																																																																																																																																																																								
-----------------	--	--	
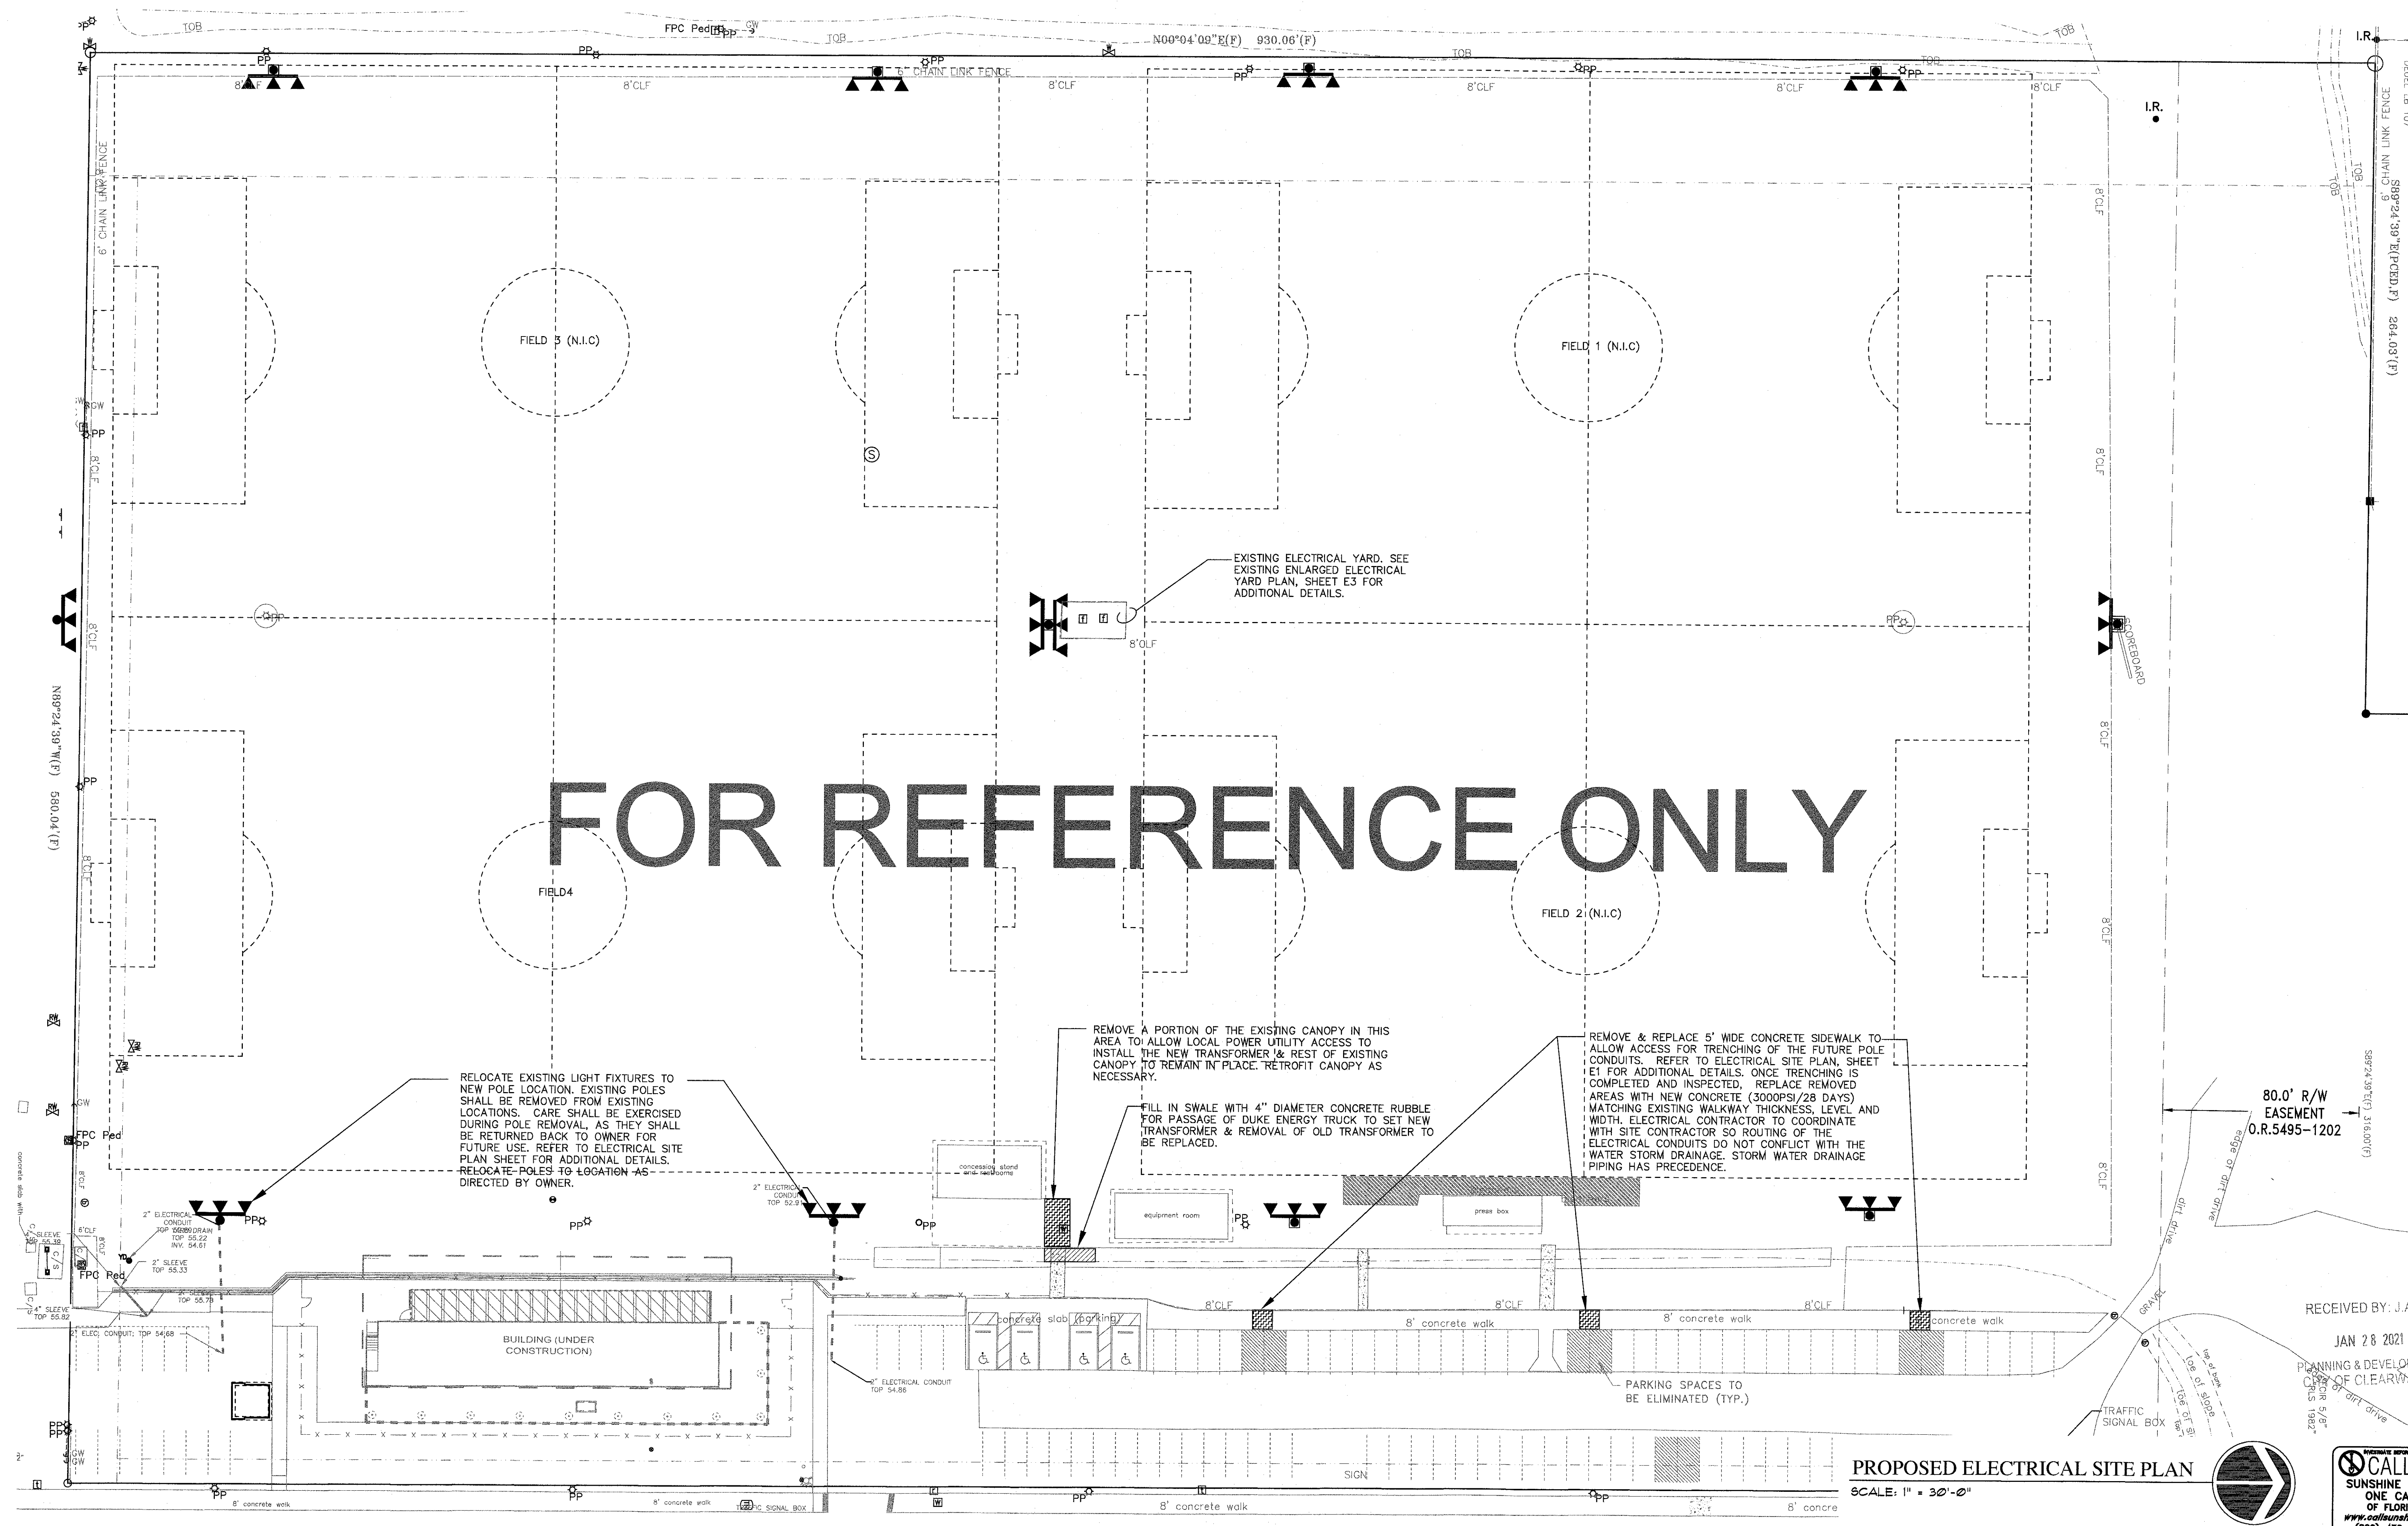

FOR REFERENCE ONLY


PROPOSED ELECTRICAL SITE PLAN
SCALE: 1" = 30'-0"

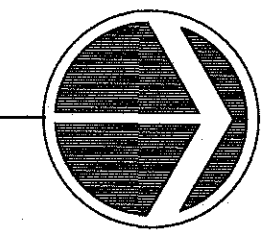

RECEIVED BY: J.A.W.
JAN 28 2021
PLANNING & DEVELOPMENT
CITY OF CLEARWATER
CITY ENGINEER

CALL 811
SUNSHINE STATE
ONE CALL
OF FLORIDA
www.call811.com
(800) 432-4770
MIN. 48 HOURS
BEFORE YOU DIG

RECORD DRAWINGS	
SURVEYED BY	DRAWN BY
REVIEWED BY	PROJECT ENGINEER
APPROVED BY	CITY ENGINEER MICHAEL D. GUILLEN, P.E. # 33721
DATE	DATE

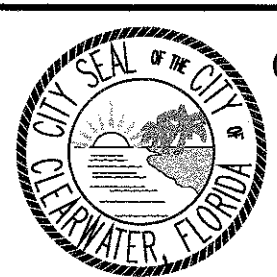

CITY OF CLEARWATER, FLORIDA
PARKS & RECREATION DEPT.
100 S. Myrtle Ave.
Clearwater, FL 33756

GRINER

GRINER ENGINEERING, INC.
1628 First Avenue North
St. Petersburg, Florida 33713
Phone: (727) 822-2335
Fax: (727) 821-3361
Certificate of Authorization #3173

Date: 09/27/19
Drawn: SK
Designed: JAR
EOR: JAR
Job no.: 19139

COUNTRYSIDE SPORTS COMPLEX
FIELD 3 AND 4 RENOVATION
ELECTRICAL EXISTING
CONDITION - DEMO PLAN

DRAWN BY	SK/JAR	DESIGNED BY	JAR	CHECKED BY	JAR	CLEARWATER CONTRACT NO.
SCALE	VERT. NONE	SURVEYED BY	Clearwater	BOOK NO.		CLEARWATER JOB NO.
HORIZ.	1"=N/A	DATE DRAWN	Nov 24, 2019	DWG NAME	2019-XXXX	SHEET NO. 8
JOSE A. ROSARIO, P.E. 74457						DATE


POLE FEEDER SCHEDULE

ASSUMED FEEDER LOAD PER PANEL SCHEDULE FOR EACH POLE. THE DATA BELOW WAS GENERATED FOLLOWING THE FLORIDA BUILDING CODE - ENERGY CONSERVATION CODE CHAPTER 505.7.3.2 - BRANCH CIRCUITS

FIELD POLE	EST. DISTANCE (FT)	WIRE SIZE (COPPER)	CONDUIT SIZE (IN)
S10	360 FT	(4-2/0 + 1#6 EG)	2"
S11	640 FT	(4-4/0 + 1#4 EG)	2-1/2"
P6	560 FT	(4-2/0 + 1#6 EG)	2"
P3	100 FT	(4-#3 + 1#8 EG)	1-1/2"
P8 (BID ADD ALT 1)	525 FT	(4-4/0 + 1#4 EG)	3"

ELECTRICAL LINES GUIDE

— LGT — LGT — LGT — LGT — LGT —	CONDUIT FOR POLE LIGHTING
— C — C — C — C — C —	SPARE CONDUIT
— — — — —	SCORE BOARD CONDUIT

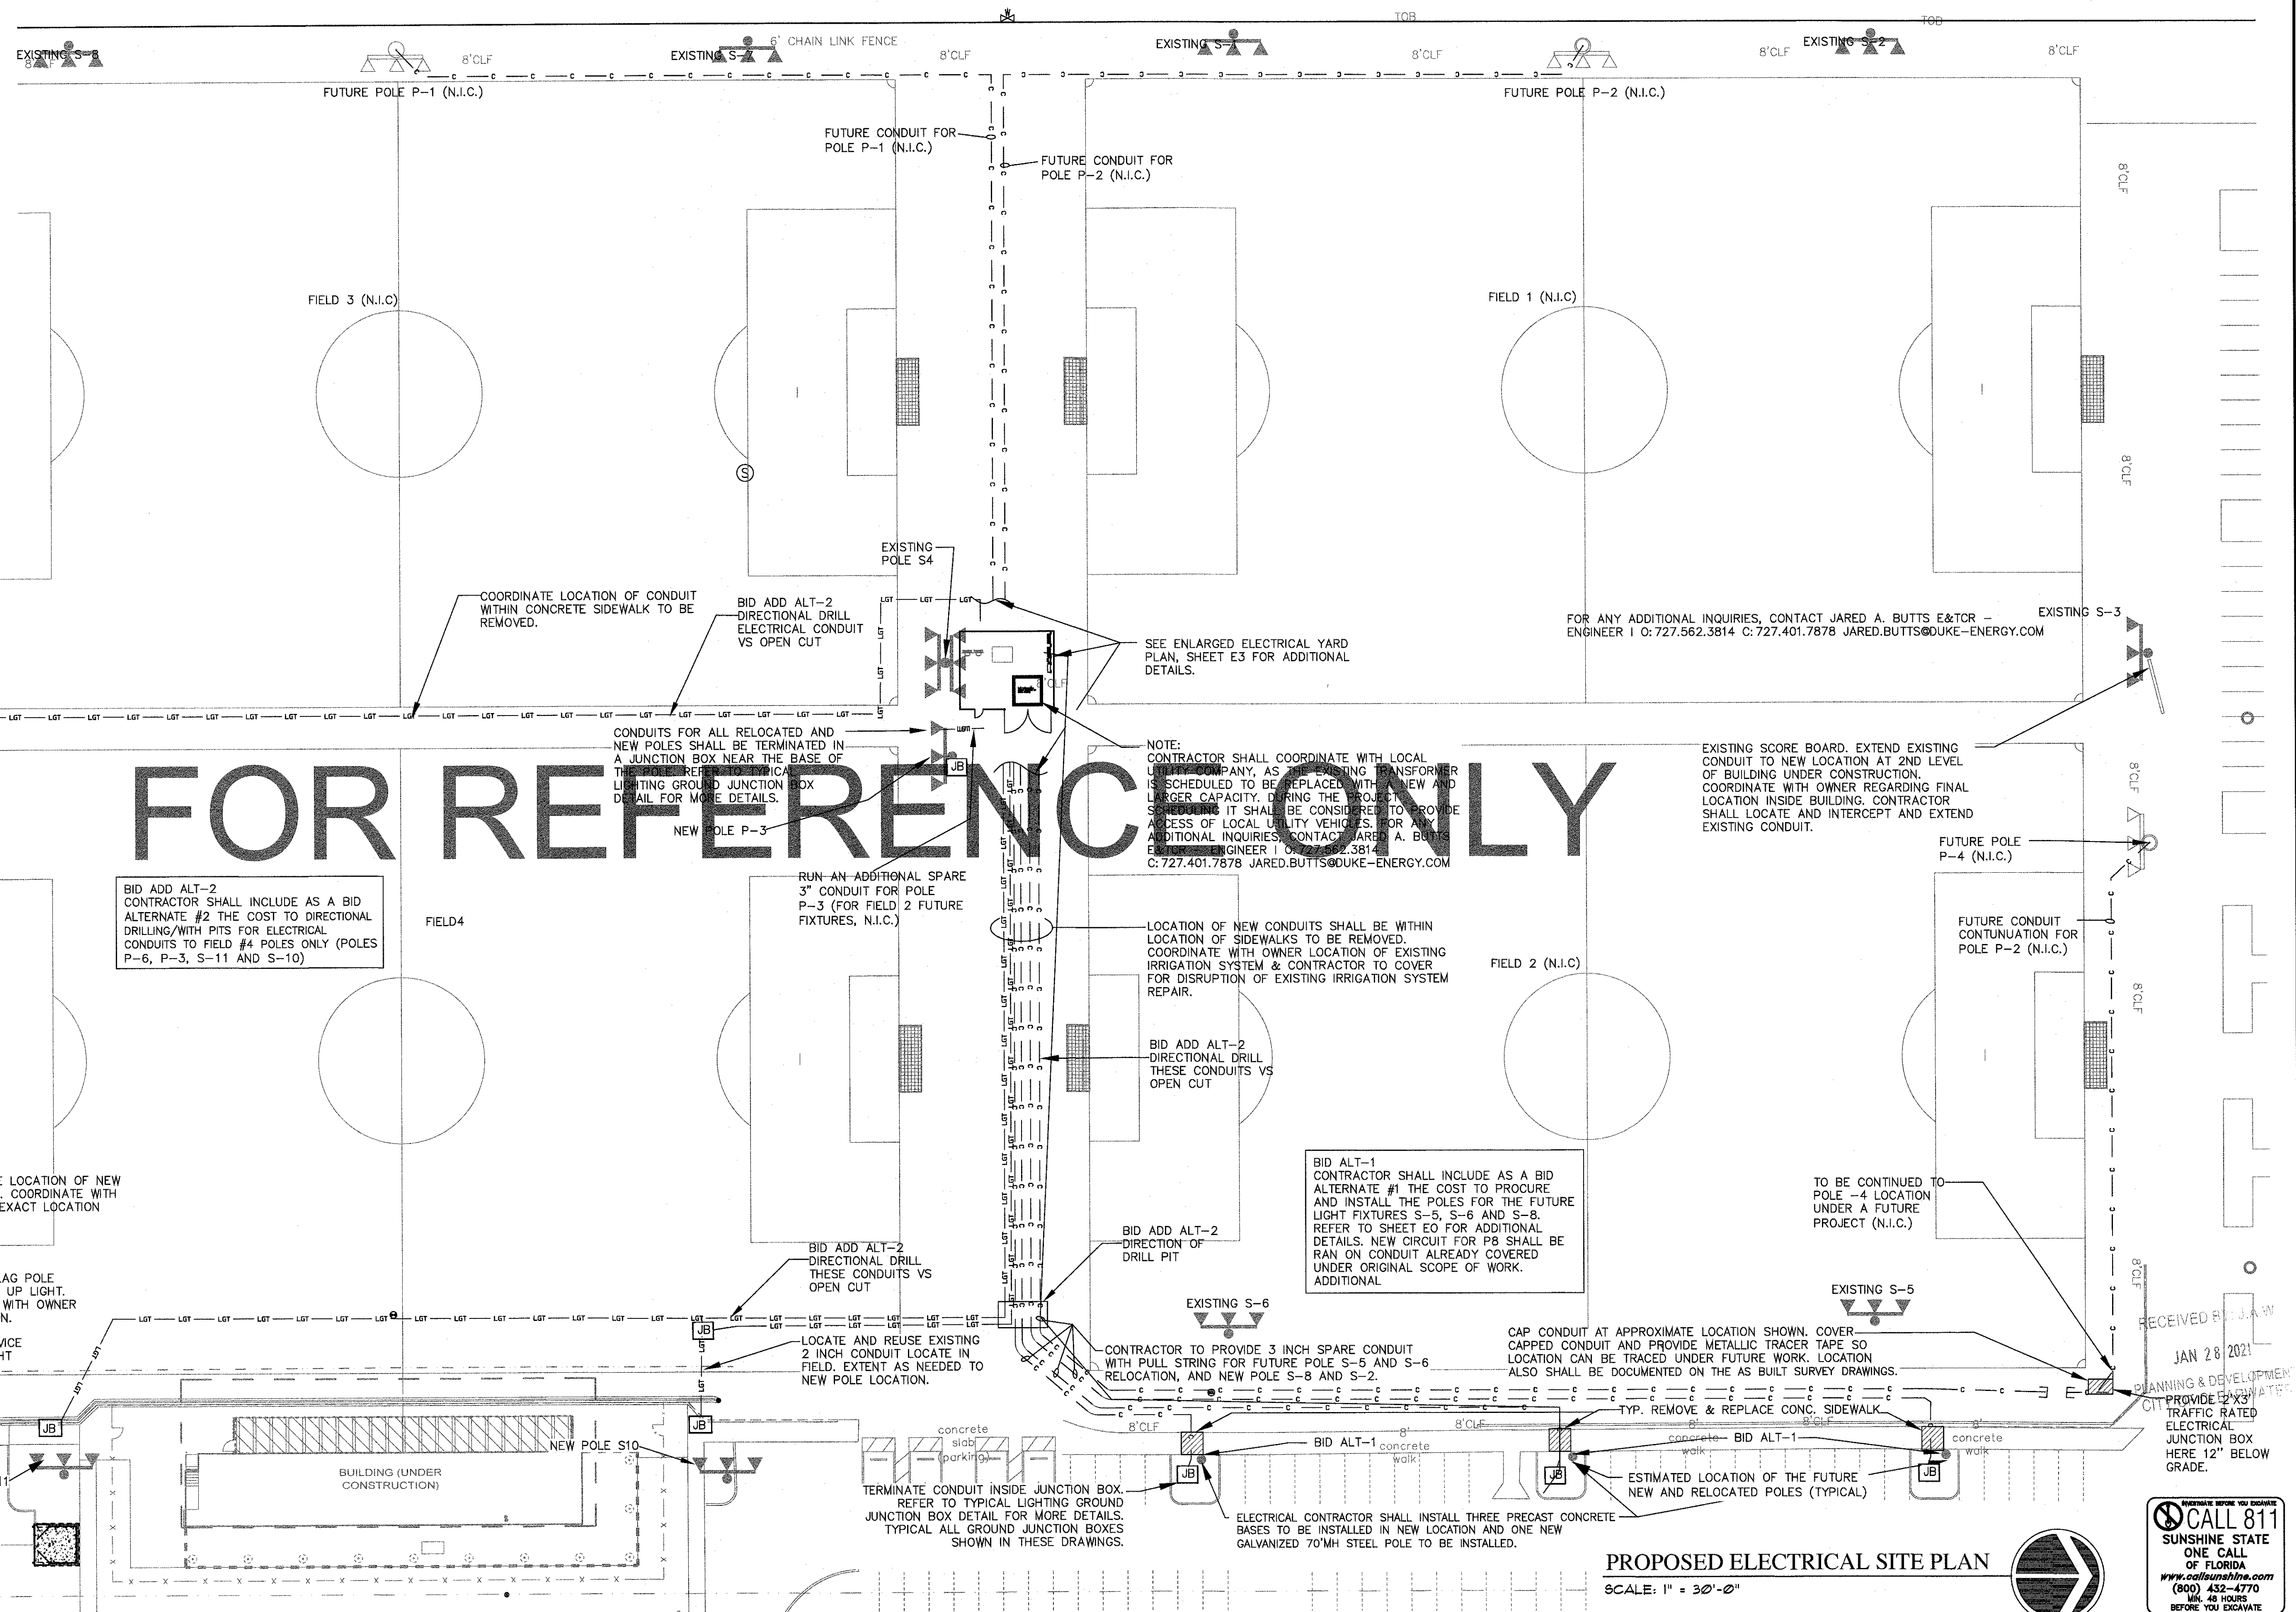


PROPOSED ELECTRICAL SITE PLAN

SCALE: 1" = 30'-0"

RECEIVED BY JAW
JAN 28 2021
PLANNING & DEVELOPMENT
CITY OF CLEARWATER
PROVIDE 12" TRAFFIC RATED ELECTRICAL JUNCTION BOX HERE 12" BELOW GRADE.

CALL 811
SUNSHINE STATE
ONE CALL
OF FLORIDA
www.call811.com
(800) 432-4770
MIN. 48 HOURS
BEFORE YOU EXCAVATE

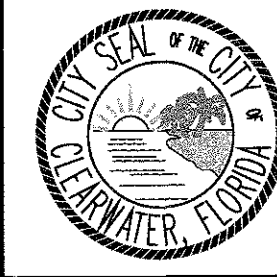

CITY OF CLEARWATER, FLORIDA
PARKS & RECREATION DEPT.
100 S. Myrtle Ave.
Clearwater, FL 33756

GRINER
GRINER ENGINEERING, INC.
1628 First Avenue North
St. Petersburg, Florida 33713
Phone: (727) 822-2335
Fax: (727) 821-3361
Certificate of Authorization #3173

COUNTRYSIDE SPORTS COMPLEX
FIELD 3 AND 4 RENOVATION
ELECTRICAL SITE PLAN

DRAWN BY SK/JAR	DESIGNED BY Clearwater	CHECKED BY JAR	CLEARWATER CONTRACT NO.
SCALE VERT. NONE	SURVEYED BY Nov 24, 2019	BOOK NO.	CLEARWATER JOB NO.
HORIZ. 1"=N/A	DATE DRAWN Nov 24, 2019	DWG NAME 2019-XXXX	SHEET NO. 9
JOSE A ROSARIO, P.E. 74457			DATE

RECORD DRAWINGS		REVISION	
SURVEYED BY	DRAWN BY	BY	DATE
REVIEWED BY	PROJECT ENGINEER	DATE	
APPROVED BY	CITY ENGINEER MICHAEL D. GUILLEN, P.E. # 33721	DATE	

EXISTING PANEL 'B'				SURFACE MOUNTED 120/208 VOLT 3 PHASE 4 WIRE WITH GROUND										400 MCB 120/208V, 75C"														
														22,000 AIC														
WIR E	COND	LOAD TYPE	CKT. NO.	DESCRIPTION			BREAKER TRIP POLE VOLT			A		B		C		BREAKER VOLT POLE TRIP			DESCRIPTION			CKT. NO.	LOAD TYPE	COND.	WIRE SIZE			
		L 1	1	EX POLE S7 (7 FIX.)			60	3	208							208	3	100	EX POLE S4 (13 FIX.)			2	L					
		L 3	3																				4	L				
		L 5	5																					6	L			
		L 7	7																					8	L			
		L 9	9	NEW POLE S10 (13 FIX)			100	3	208							208	3	100	EX POLE S9 (13 FIX.)			10	L					
		L 11	11																					12	L			
		L 13	13				SPARE	20	1	120															14	L		
		L 15	15				SPARE	20	1	120																16	L	
		L 17	17	SPARE			20	1	120												18	L						
		L 19	19	EX POLE S8 (7 FIX.)			60	3	208												20	L						
		L 21	21																				22	L				
		L 23	23																				24	L				
		L 25	25																				26	L				
		L 27	27	SPACE												208	3		SURGE PROTECTION			28	L					
		L 29	29																							30	L	
CONNECTED VA							0		0		0		0		0		0											
CONNECTED PHASE AMPS							0		0		0		0		0		0											
PHASE BALANCE							33.33%		33.33%		33.33%		33.33%		100%													
LOAD TYPE				CONNECTED			NEC DEMAND			DEMAND LOAD																		
L LIGHTING				0			1.25			0			VA															
R RECEPTACLES				0			1			0			VA															
AC AIR CONDITIONING				0			0			0			VA															
H HEATING				0			0			0			VA															
M MISC. NON-CONTINUOUS				0			1			0			VA															
C CONTINUOUS				0			1.25			0			VA															
K KITCHEN				0			0.65			0			VA															
							TOTAL			0			VA															
				120/208, 3 PHASE									527 AMPS															
1.00 P.F. CORRECTION																												
BASED ON INFORMATION BY DUKE ENERGY THE PEAK KW DEMAND FOR THIS METER SERVING THIS PANEL IS 88 KW. HENCE THE TOTAL LOAD CURRENT IS APPROXIMATELY 244 A. HOWEVER, THE LOAD HAS BEEN REVISED TO REFLECT THE NEW LOAD OF POLE S10 AND THE RELOCATION OF POLE S11.																												



SCALE: N.T.S.




NOT TO SCALE



CONTRACTOR SHALL PROVIDE DECAL 1-1/2" x 2-1/2" WITH 3/16" LETTERING STATING THE A.I.C. RATING OF EACH PANEL. THIS DECAL SHALL BE LOCATED ON THE INSIDE OF PANEL DOOR. DECAL SHALL BE WHITE BACKGROUND WITH BLACK LETTERING WITH A CLEAR PLASTIC LAMINATE TOP COVER OVER DECAL.

A.I.C. IDENTIFICATION DECAL

NOT TO SCALE

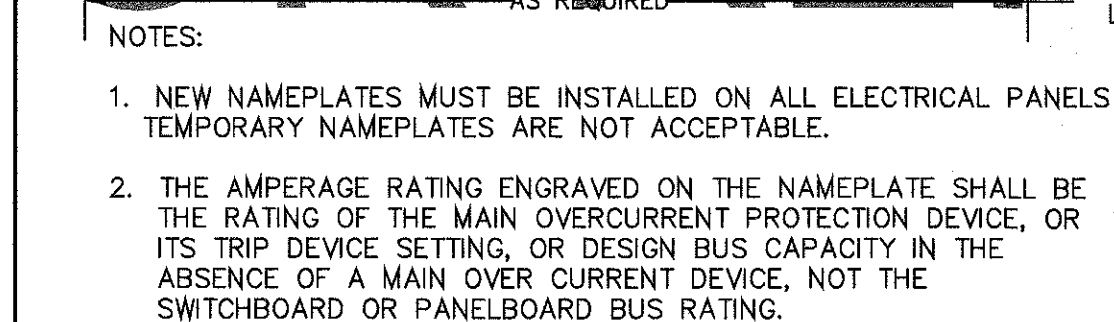

TYPICAL PANELBOARD NAMEPLATE DETAIL

NOT TO SCALE



CONTRACTOR SHALL PROVIDE DECAL 1-1/2" x 2-1/2" WITH 3/16" LETTERING STATING THE ABOVE. DECAL SHALL BE LOCATED ON THE OUTSIDE OF ALL SWITCHBOARDS, PANEL BOARDS AND DISCONNECT SWITCHES. DECAL SHALL BE RED AND YELLOW BACKGROUND WITH BLACK LETTERING WITH A CLEAR PLASTIC LAMINATE TOP COVER OVER DECAL.

FLASH PROTECTION DECAL

NOT TO SCALE

800S	(SERVICE - 800 AMPS) (3) SETS OF 4 #350 MCM, IN 3" C.	NOT APPLICABLE
800	(FEEDER - 800 AMPS) (3) SETS OF 4 #350 MCM, 1 #1/0 E.G. COPPER COND. IN 3" C.	NOT APPLICABLE
600	(FEEDER - 600 AMPS) (2) SETS OF 4 #350 MCM, 1 #1 E.G. COPPER COND. IN 2-1/2" C.	(FEEDER - 600 AMPS) (2) SETS OF 4 #500, 1 #2/0 E.G. ALUMINUM COND. IN 3" C.
400S	(FEEDER - 400 AMPS - MORE THAN 400 FT. LONG) (2) SETS OF 4 #3/0 AND 1 #3 E.G. COPPER COND. IN 2" C.	(FEEDER - 400 AMPS) (2) SETS OF 4 #250MCM AND 1 #1/0 E.G. ALUMINUM COND. IN 3" C.
400	(FEEDER - 400 AMPS) (2) SETS OF 4 #3/0 AND 1 #3 E.G. COPPER COND. IN 2" C.	(FEEDER - 400 AMPS) (2) SETS OF 4 #250MCM AND 1 #1/0 E.G. ALUMINUM COND. IN 3" C.
250	(FEEDER - 250 AMPS) 4 #350, AND 1 #4 EG. COPPER COND. IN 3" C	(FEEDER - 250 AMPS) 4 #500, AND 1 #3/0 EG. ALUMINUM COND. IN 3-1/2" C
200	(FEEDER - 200 AMPS) 4 #4/0 AND 1 #4 E.G. COPPER COND. IN 2-1/2" C	(FEEDER - 200 AMPS) 4 #350 AND 1 #1/0 E.G. ALUMINUM COND. IN 3" C
175	(FEEDER - 175 AMPS) 4 #3/0 AND 1 #6 E.G. COPPER COND. IN 2" C	(FEEDER - 175 AMPS) 4 #250 AND 1 #4 E.G. ALUMINUM COND. IN 2-1/2" C
125	(FEEDER - 125 AMPS) 4 #1/0 AND 1 #6 E.G. COPPER COND. IN 2" C	(FEEDER - 125 AMPS) 4 #3/0 AND 1 #6 E.G. ALUMINUM COND. IN 2-1/2" C
100	(FEEDER - 100 AMPS) 4 #1 AND 1 #6 E.G. COPPER COND. IN 2" C	(FEEDER - 100 AMPS) 4 #2/0 AND 1 #6 E.G. ALUMINUM COND. IN 2-1/2" C


1. ELECTRICAL CONTRACTOR TO VERIFY EXISTING CONDITIONS AND TO REPORT TO GENERAL CONTRACTOR, OWNER AND ENGINEER ANY DISCREPANCY FROM THAT SHOWN ON DRAWINGS.
2. ELECTRICAL CONTRACTOR SHALL REQUEST THE DRAWINGS OF ALL OTHER DISCIPLINES APPLICABLE TO THIS SCOPE OF WORK AND CAREFULLY REVIEW ALL DRAWINGS BEFORE WORK COMMENCEMENT OR BID SUBMITTAL IS THE RESPONSIBILITY OF THE ELECTRICAL CONTRACTOR TO PROVIDE ANY ADDITIONAL DEVICE REQUIRED FOR A COMPLETE AND FULLY FUNCTIONAL WORK OF SCOPE THAT IS NOT COVERED ON THESE DRAWINGS. COORDINATE ALL NEW ELECTRICAL WORK WITH CONTRACTORS OF ALL TRADES AND OWNER.
3. PANELS ARE REQUIRED TO HAVE AN PANELBOARD NAMEPLATE PER NEC 408.4(B) SEE TYPICAL PANELBOARD NAMEPLATE DETAILS, ELECTRICAL DETAILS SHEET FOR MORE INFORMATION
4. FOR SPECIFIC EQUIPMENT LOCATION, REFER TO ARCHITECTURAL DRAWINGS
5. ALL ELECTRICAL RUNS SHALL BE NO LEEES THAT AWG #12 COPPER CONDUCTORS, UNLESS OTHERWISE NOTED.
6. AN EQUIPMENT GROUNDING CONDUCTOR SHALL BE INSTALLED IN ALL ELECTRICAL RACEWAYS AND SHALL BE SIZED IN ACCORDANCE WITH ARTICLE 250-122 OF THE NATIONAL ELECTRICAL CODE.
7. ALL PANELS SHALL HAVE AN AIC AND SCOR OF 22,000 AMPS MINIMUM.



1. REFER TO SITE DRAWINGS FOR ADDITIONAL CONDUIT AND CONDUCTOR DETAILS.
2. JUNCTION BOX SHALL BE TRAFFIC RATED AND MADE OF CONCRETE FIBER, TYPICAL FOR JUNCTION BOX AND LID.
3. ANY ELECTRICAL JUNCTION BOXES LOCATED IN PLAY FIELD SHALL BE LOW GRADE MINIMUM 12" FROM FINISH GRADE. SURVEY POINTS SHALL BE PROVIDE TO CENTER OF J-BOX FOR FUTURE LOCATION OF ELECTRICAL J-BOX.

TYPICAL LIGHTING GROUND JUNCTION BOX

NOT TO SCALE

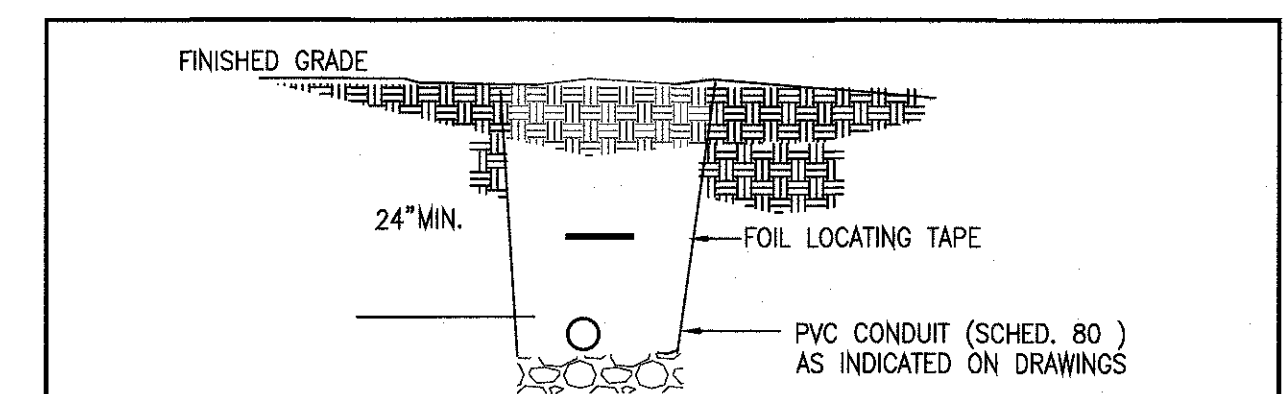


TYPICAL SERVICE TRENCH CONFIGURATION

NOT TO SCALE




CITY OF CLEARWATER, FLORIDA
PARKS & RECREATION DEPT.
100 S. Myrtle Ave.
Clearwater, Fl 33756

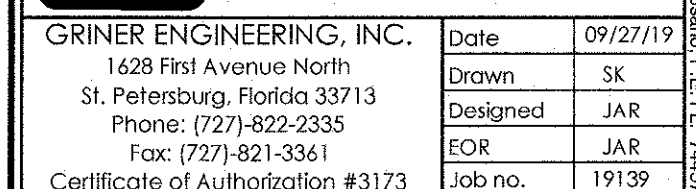

COUNTRYSIDE SPORTS COMPLEX
 FIELD 3 AND 4 RENOVATION
 REVISED ELECTRICAL RISER DIAGRAM

DRAWN BY SK/JAR		DESIGNED BY		CHECKED BY JAR		CLEARWATER CONTRACT N	
SCALE VERT. NONE		SURVEYED BY Clearwater		BOOK NO.		CLEARWATER JOB NO.	
HORIZ. 1"=N/A		DATE DRAWN Nov 24, 2019		DWG NAME 2019-XXXX		SHEET NO. 11	
JOSE A ROSARIO, P.E. 744657						DATE	

RECEIVED BY: J.A.W.
JAN 28 2021
PLANNING & DEVELOPMENT
CITY OF CLEARWATER

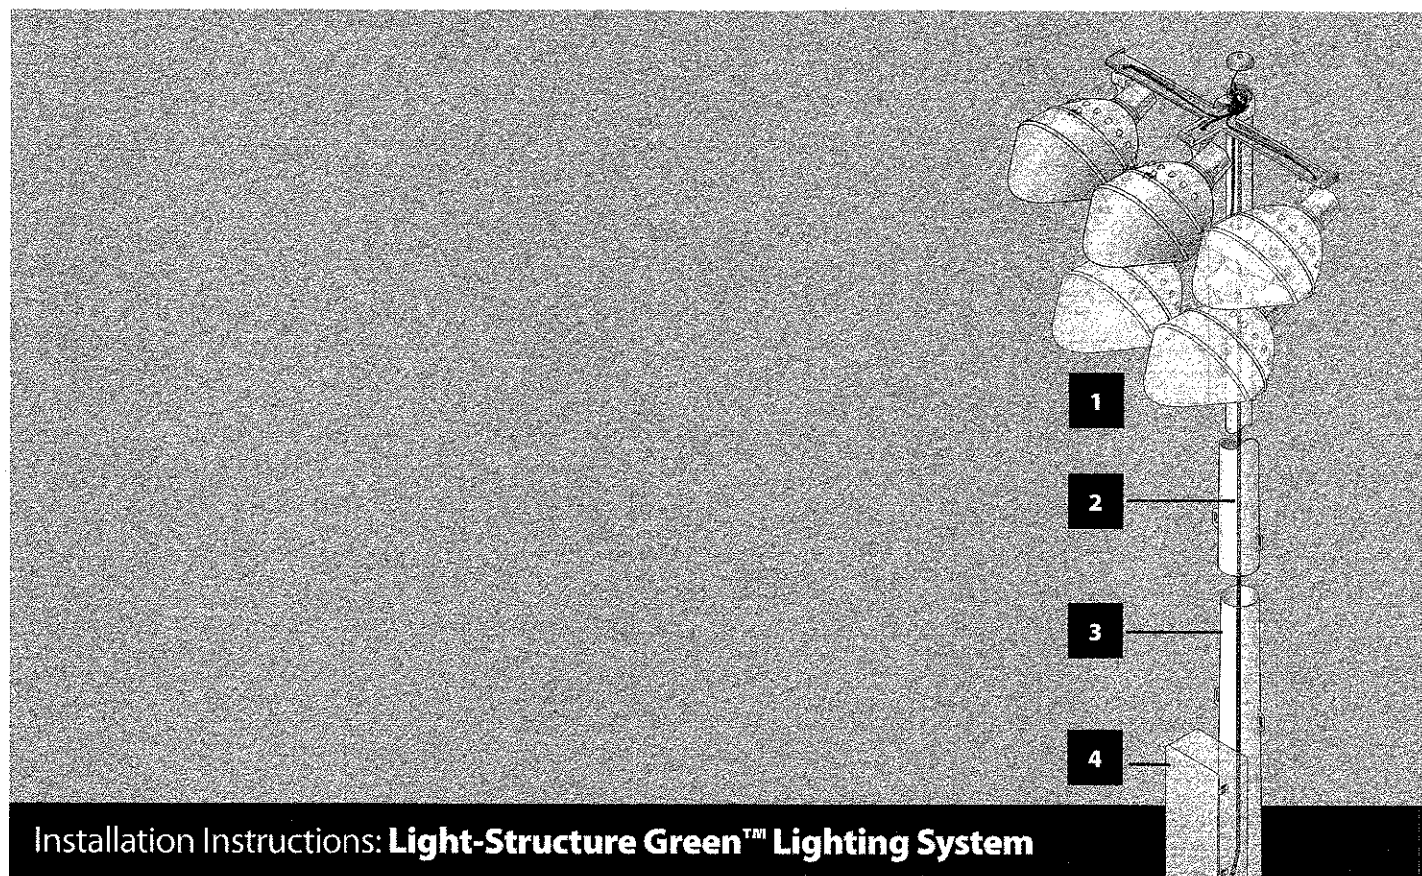

Fast, trouble-free installation with 5 Easy Pieces™ approach to system design

- 1 Poletop Luminaire Assembly
- 2 Wire Harness
- 3 Galvanized Steel Pole
- 4 Electrical Components Enclosure
- 5 Precast Concrete Base



Installation Instructions: Light-Structure Green™ Lighting System

Before You Begin

Standard Tools/Supplies Checklist

Contractor/Installer supplied tools	Function	Page
Hammer, pry-bar, banding cutters	Unloading equipment	7
Water pump	Removing water from base holes (as needed)	9
Two 1½ ton chain-type come-alongs	Jacking pole sections together	11, 21
Large Phillips-head screwdriver	Tightening captive screws to seal enclosure to pole hub	14
Standard screwdriver	Tightening distribution lugs, 45 A disconnect switch	22, 23
Electrical fish tape, electrician's tape	Feeding wire harness through pole	15
Spray paint, chalk, or flags	Marking points to sight in aiming	17
Chalk or pencil	Making alignment marks	21
10 ft (3m) stepladder or small line truck	Connecting supply wires to electrical enclosure	22, 23
Musco supplied tools	Function	Page
Wooden base wedges	Setting base	9
Level with shim for base taper	Plumbing base	9
Steel bar	Setting base, seating pole on base	9, 21
¾ inch hex key	Attaching handhole covers on base and steel pole	8, 15, 23
¾ inch wrench	Tightening poletop self screw, pole cap fastener, and electrical components enclosure hinge bolt	12, 14, 15
Dishwashing liquid (original Dawn® brand)	Lubricating pole slip-fit connections	11, 17
Wooden shipping blocks	Elevating pole sections off ground during assembly	11
¾ inch ratcheting combination wrench	Tightening captive bolts to secure luminaire assembly	16
Pole rotorator kit	Guiding pole onto base, pole alignment	17, 19, 20
Steel chain	Setting pole on base	21
5 mm hex key	Latching primary feed wires on 125 A disconnect switch	23
¾ inch hex key	Attaching grounding conductors inside electrical enclosure	22, 23
¾ inch hex key	Attaching grounding conductors inside pole at handhole	23
Machinery needed	Function	Page
Crane or forklift with nylon strapping and 8 ft (2.5 m) sling (sized to weight of base)	Unloading materials, setting bases	7, 9
Auger	Boring holes for bases	8
Load-rated crane, nylon slings, and shackles	Setting poles	16, 19, 20

Documents You Need

- ☐ Musco Foundation and Pole Assembly Drawing
- ☐ Field Aiming Diagram
- ☐ Alternate foundation design (optional, as needed)
- ☐ Control System Summary

If you do not have all of these documents, contact Musco at +1-800-825-6020 or call your local representative.



©1991, 2012 Musco Sports Lighting, LLC - M-1001-ends-14
www.musco.com - lighting@musco.com

Installation Instructions: Light-Structure Green™ Lighting System

Before You Begin

Electrical System Requirements

While the majority of the Light-Structure Green lighting system can be assembled by non-professionals, a qualified electrician must handle the electrical supply installation and hook-up in accordance with national, state, and local codes. Your electrician should review this information before installation begins.

The electrician is generally required to provide these items:

- Service entrance
- Main power disconnect and distribution panel(s)
- Supply wiring and equipment grounding conductors

Ensure supply wiring is rated for 90 °C. Review the label inside the electrical components enclosure door and Control System Summary for voltage and phase requirements.

Always dispose of lamps and other electronic waste in accordance with all applicable laws and regulations.

Other features that may affect the wiring supply requirements for this project include:

- Lighting contactor cabinets — refer to the supplemental installation instructions and the Musco Control System Summary.
- Control-Link™ system — refer to the supplemental installation instructions and Musco Control System Summary.
- Auxiliary bracket option — customer supplies all wiring for auxiliary components.
- Momentary Power Interruption (MPI) luminaire — refer to the supplemental installation instructions

Volunteer Installation


Have a qualified electrician review and complete the following:

- Create electrical system design — prior to installation.
- Provide and install trenching, supply wiring, and conduit.
- Complete all steps from Connecting to Supply Wiring section.
- Test complete lighting system.

Components Matching and Labeling


Pole locations are identified by a pole ID (A1, A2, B1, B2, etc.) on the Field Aiming Diagram. These IDs are also marked on the individual components.

- Poletop luminaire assemblies and luminaire shipping cartons
- Wire harnesses
- Electrical components enclosures
- Galvanized steel pole sections
- Precast concrete bases

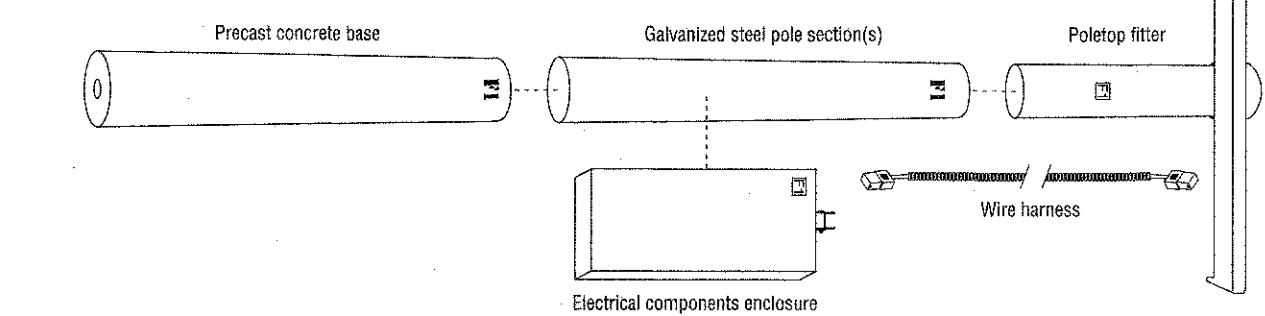

©1991, 2012 Musco Sports Lighting, LLC - M-1001-ends-14
www.musco.com - lighting@musco.com

INFORMATION ON THIS SHEET IS FOR REFERENCE ONLY AND DOES NOT CONSTITUTE A CONTRACT.

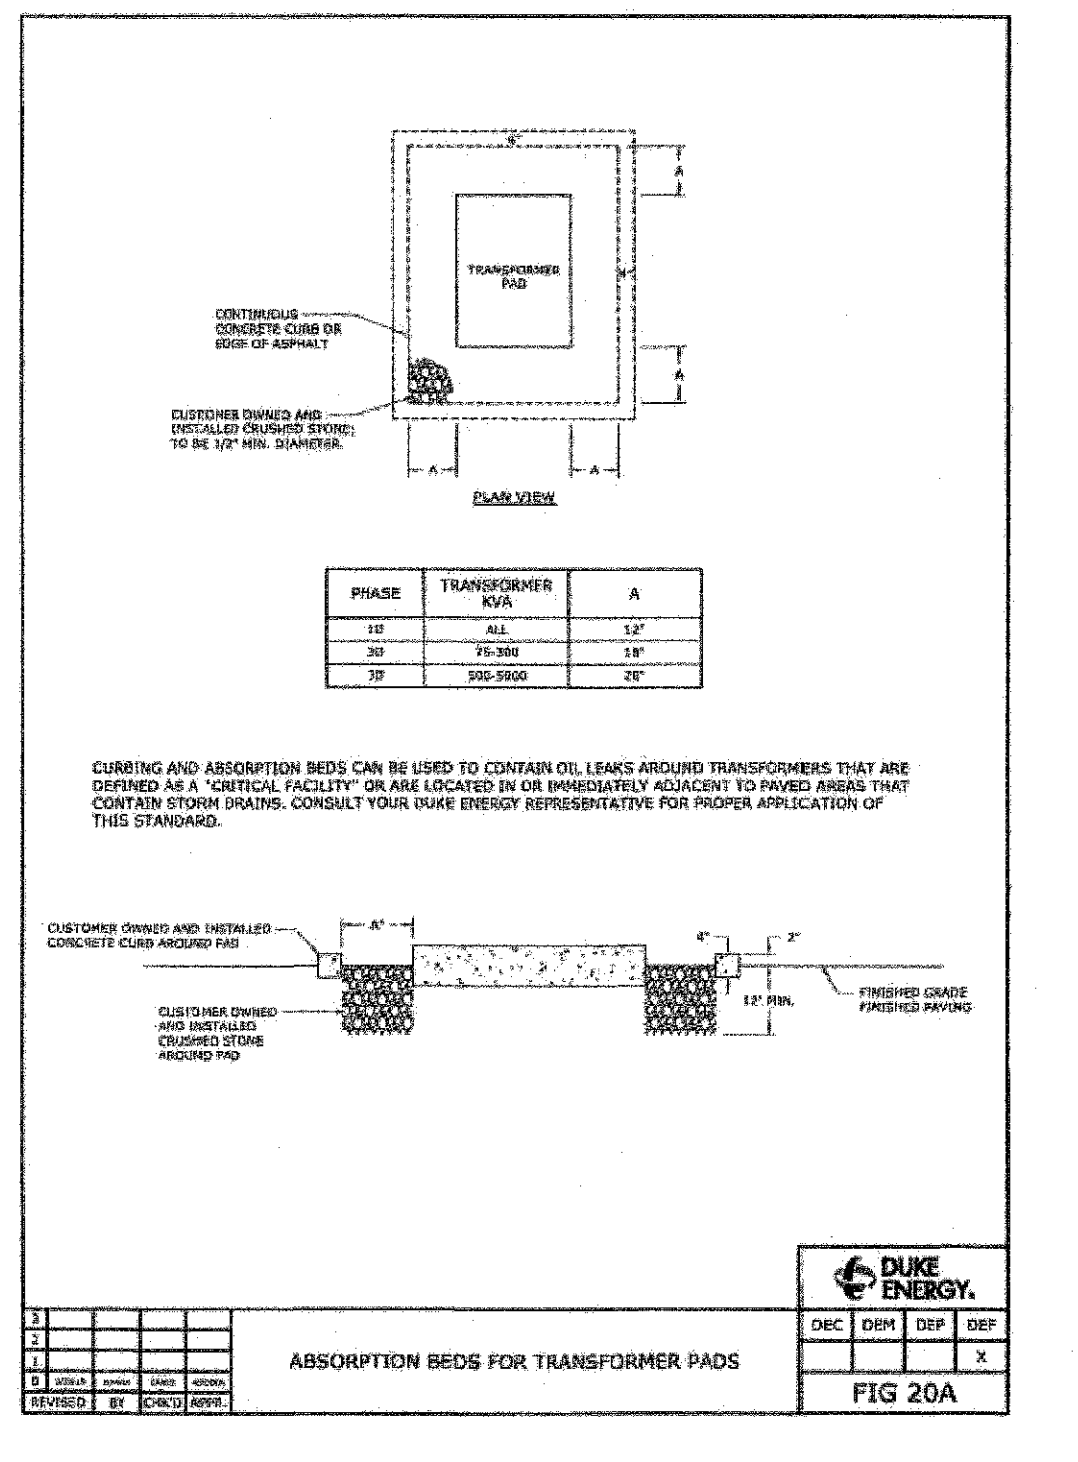

UTILITY CONTACT INFORMATION

FOR TRANSFORMER COORDINATION INQUIRIES,
CONTACT JARED A. BUTTS E & TCR— ENGINEER I
CONTACT: 727.562.3814 (OFF), 727.401.7878
EMAIL: JARED.BUTTS@DUKE-ENERGY.COM



1. CUSTOMER TO PROVIDE ALL NECESSARY PERMITS AND APPROVALS PRIOR TO INSTALLATION.
2. THE GROUND SHALL BE LEVELED AND THOROUGHLY COMPACTED BEFORE THE PAD IS INSTALLED.
3. THERE SHALL BE NO ABOVE GROUND OBSTRUCTIONS WITHIN 15 FEET OF THE FRONT OF THE TRANSFORMER OR WITHIN 10 FEET OF THE REAR AND SIDE. IF METEERING TROUGH IS LOCATED BEHIND TRANSFORMER, MINIMUM CLEARANCE BETWEEN BACK OF TRANSFORMER AND CLOSEST PART OF TROUGH IS 6 FEET.
4. SOG MAY BE REQUIRED AROUND PAD TO PREVENT EROSION, AS DETERMINED BY A DUKE REPRESENTATIVE.
5. SIDE VENTILATION MAY BE REQUIRED IF THERE IS A WALL CONSTRUCTED AROUND THE TRANSFORMER.
6. IF THE CUSTOMER PLANS TO RUN A NUMBER OF CONDUITS BEYOND THE MAXIMUM ALLOWED, A JUNCTION BOX MAY BE REQUIRED FOR TERMINATION OF THE CUSTOMER'S CONDUITS. SEE FIGURE 19C.
7. CONTACT A COMPANY ENGINEERING REPRESENTATIVE FOR DETERMINATION OF NEED FOR GROUNDING SYMBOL, CURBING AND TRAFFIC BARRIER. EXACT ORIENTATION OF THE TRANSFORMER IN THE FIELD MUST BE APPROVED BY A COMPANY ENGINEERING REPRESENTATIVE.
8. IN AREAS WHERE TRANSFORMERS ARE TO BE ELEVATED ABOVE NORMAL GRADE, ENGINEERING DEPARTMENT MUST BE CONTACTED FOR APPROVAL OF DESIGN.
9. EXTEND CONDUITS 1" ABOVE TOP OF CONCRETE PAD.
10. CONDUIT FOR DUKE ENERGY PRIMARY CABLES SHALL BE SPECIFIED BY A DUKE ENERGY REPRESENTATIVE TO BE EITHER 4" OR 6" DIAMETER AND INSTALLED BY THE CUSTOMER PRIOR TO POURING AND INSTALLING THE CONCRETE PAD. THERE SHALL BE TWO PRIMARY CONDUITS INSTALLED (ONE FOR EACH SET OF THREE) PRIMARY CABLES. THE CONDUIT SHALL BE A SCHEDULE 40 ELBOW WITH A 36" RADIUS.
11. INSTALL CONDUIT END BELL'S WHERE CABLES EXIT CONDUITS IN THE PRIMARY AND SECONDARY COMPARTMENTS OF THE TRANSFORMER TO MINIMIZE DAMAGE TO THE CABLES DURING INSTALLATION.
12. CUSTOMER SHALL INSTALL THE CONDUIT FOR THE PRIMARY CONDUITS AS CLOSE TO THE CENTER OF THE DESIGNATED PRIMARY SIDE OF THE WINDOW OF THE PAD AS PRACTICAL.
13. CUSTOMER'S SERVICE CONDUITS SHALL NOT CROSS OR INTERFERE WITH THE PRIMARY CONDUITS. (THE SERVICE CONDUIT CAN EXIT THE SECONDARY SIDE EITHER COMING OUT THE FRONT, THE RIGHT SIDE, OR THE BACK.)
14. THE SERVICE CONDUITS SHALL NOT EXTEND OUTSIDE THE DESIGNATED SECONDARY SIDE OF THE WINDOW OF THE PAD.

CONDUIT AND CONCRETE SPECIFICATIONS			
CONDUIT	DEM	DEP	DEF
1			
2			
3			
APPROVED SUPPLIER OF PRE-FABRICATED CONCRETE PADS			
PRE-CAST PAD SUPPLIER NUMBER			
ENDCORE PRECAST	OLDCASTLE PRECAST	PBC PRECAST	TRENWA
SMALL FLAT PAD	TRPAD082066	SEE CONTACT BELOW	FP82666
LARGE FLAT PAD	TRPAD098104	SEE CONTACT BELOW	FP981046
ENDCORE PRECAST	CONTACT: JIM MALONEY	PBC PRECAST	CONTACT: JOHNATHAN AVERY
PHONE: 513.726.5678	X22	PHONE: 910.260-1820	X22
EMAIL/WEBSITE: WWW.ENDCOREPRECASTLLC.COM		EMAIL/WEBSITE: WWW.PBCPRECAST.COM	
OLDCASTLE PRECAST	CONTACT: ALEX PALOMEUQUE	TRENWA	CONTACT: GEORGE SCHURR
PHONE: 704.788.4050		PHONE: 859.781.0831	X22
EMAIL: Alex.Palomieu@oldcastle.com		EMAIL/WEBSITE: WWW.TRENWA.COM	
WEBSITE: WWW.OLDCASTLEINFRASTRUCTURE.COM			


PROPOSED PHOTOMETRIC SITE PLAN

SCALE: 1/32" = 1'-0"

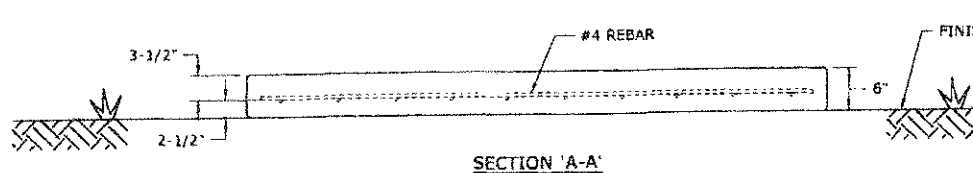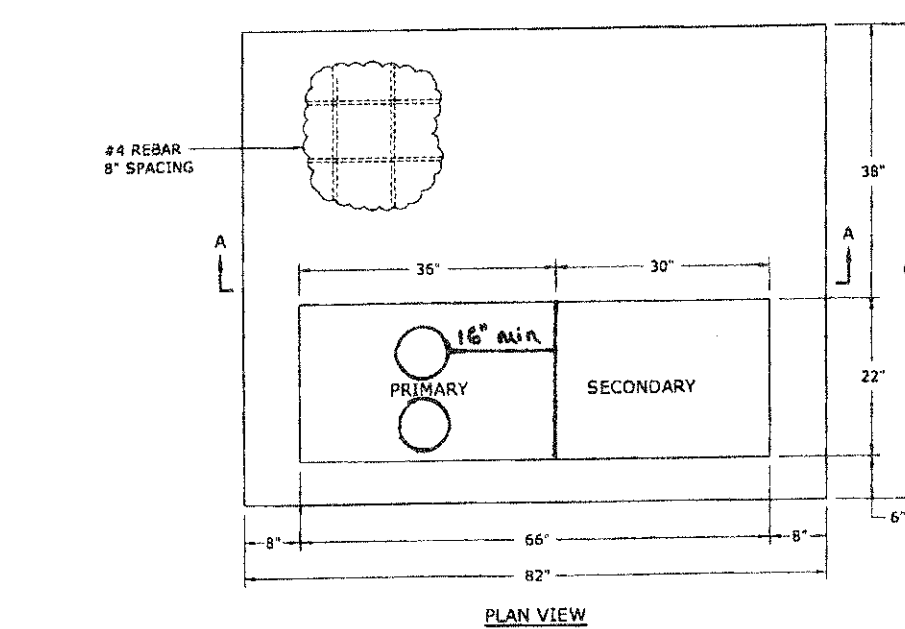

NOTES:
1. SEE FIGURE 19B FOR NOTES.

FLAT PADS FOR THREE-PHASE
PAD-MOUNTED TRANSFORMERS 75KVA - 300KVA

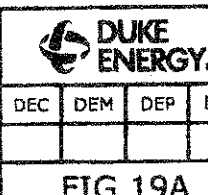

MY PROJECT	
Name:	Countryside Athletic Complex Redesign
Location:	Clearwater, FL

GRID SUMMARY	
Name:	Soccer 4
Size:	360.0' x 225.0'
Spacing:	30.0' x 30.0'
Height:	3.0' above grade

CONSTANT ILLUMINATION	
SUMMARY	HORIZONTAL FOOTCANDLES
Entire Grid	
Scan Average:	66.7
Maximum:	95
Minimum:	50
Avg / Min:	1.34
Max / Min:	1.91
UG (adjacent pts):	1.46
CU:	0.41
CV:	0.17
Application Efficacy:	34.8
No. of Points:	96
LUMINAIRE INFORMATION	
Luminaire Type:	Green Generation
Design Usage Hours:	5,000 hours
Design Lumens:	134,000
Avg Lamp Tilt Factor:	1.000
No. of Luminaires:	106
Avg KW:	165.78 (180.2 max)

Guaranteed Performance: The CONSTANT ILLUMINATION described above is guaranteed for the design usage hours of the system.

Field Measurements: Illumination measured in accordance with IESNA RP-6-15 and CIBSE LG4. Individual values may vary. See the Warranty document for details.

Electrical System Requirements: Refer to Amperage Draw Chart and/or the "Musco Control System Summary" for electrical sizing.

Installation Requirements: Results assume +/- 3% nominal voltage at line side of the ballast and structures located within 3 feet (1m) of design locations.

JAN 28 2021
PLANNING & DEVELOPMENT
CITY OF CLEARWATER

RECORD DRAWINGS

SURVEYED BY	DRAWN BY
REVIEWED BY	PROJECT ENGINEER
DATE	
APPROVED BY	CITY ENGINEER MICHAEL D. QUILLLEN, P.E. # 33721
DATE	

REVISION

BY DATE



CITY OF CLEARWATER, FLORIDA
PARKS & RECREATION DEPT.
100 S. Myrtle Ave.
Clearwater, FL 33756




GRINER ENGINEERING, INC.
1628 First Avenue North
St. Petersburg, Florida 33713
Phone: (727)-822-2335
Fax: (727)-821-3361
Certificate of Authorization #3173

Date: 09/27/19
Drawn: SK
Designed: JAR
EOR: JAR
Job no.: 19139

COUNTRYSIDE SPORTS COMPLEX
FIELD 3 AND 4 RENOVATION
PHOTOMETRIC PERFORMANCE DATA

DRAWN BY	SK/JAR	DES/PAIGNED BY	CHECKED BY	JAR	CLEARWATER CONTRACT NO.
SCALE	NONE	SURVEYED BY	BOOK NO.		CLEARWATER JOB NO.
VERT.		DATE DRAWN	DWG NAME	2019-XXXX	SHEET NO.
HORIZ.	1"=N/A	Nov 24, 2019			12
JOSE A. ROSARIO, P.E. 74457					DATE

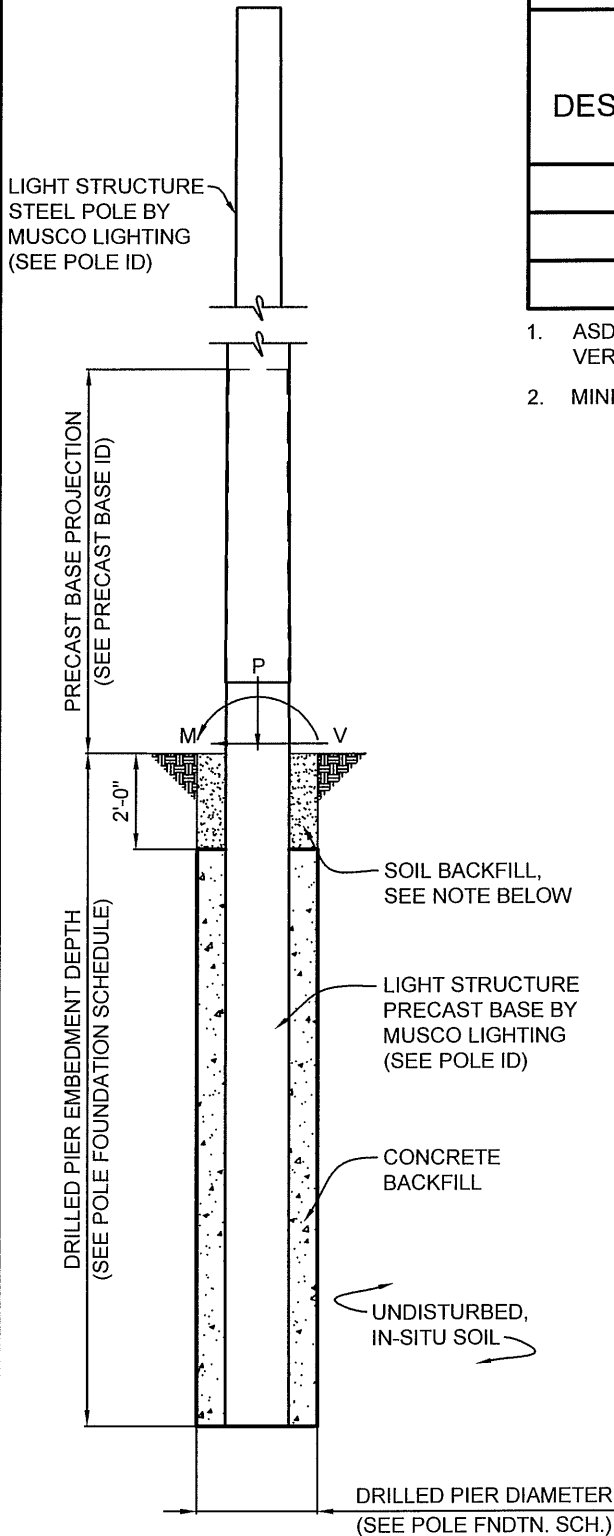

POLE FOUNDATION ELEV.

SCALE: NOT TO SCALE

SOIL BACKFILL NOTE:
THE TOP TWO FEET OF ANNULUS SHALL BE BACKFILLED WITH SOIL, WITH A CLASSIFICATION OF CLASS 4 (TABLE 1806.2) OR BETTER. COMPACTION, 95% FOR COHESIVE SOIL AND 98% FOR A COHESIONLESS SOIL BASED UPON STANDARD PROCTOR TESTING (ASTM D698).

POLE FOUNDATION SCHEDULE

POLE DESIGNATION	FORCES (1.)			DRILLED PIER		
	MOMENT (M) FT-LBS	SHEAR (V) LBS	VERTICAL (P) LBS	DIAMETER INCHES	EMBEDMENT DEPTH	CONCRETE BACKFILL YD ³ (2.)
P4	237,311	4,646	5,723	36	20'-0"	2.7
P8	174,522	3,733	3,801	30	18'-0"	1.6
S5, S6	88,595	2,184	1,917	30	14'-0"	1.6

- ASD LOAD COMBINATION D + 0.6W.
VERTICAL FORCE IS WEIGHT OF DRESSED POLE (DOES NOT INCLUDE PRECAST BASE WEIGHT).
- MINIMUM CONCRETE BACKFILL VOLUME, SITE CONDITIONS MAY REQUIRE ADDITIONAL BACKFILL.

PRECAST BASE IDENTIFICATION

PRECAST BASE TYPE	PRECAST BASE WEIGHT	PRECAST BASE LENGTH	PROJECTION ABOVE GRADE	STANDARD EMBEDMENT	OUTSIDE DIAMETER
4B	3,490 LBS	22'-0"	8'-0"	14'-0"	15.75"
6B	6,930 LBS	26'-1"	8'-1"	18'-0"	20.56"
7B	10,160 LBS	27'-10"	7'-10"	20'-0"	23.75"

POLE IDENTIFICATION

POLE DESIGNATION	POLE TYPE	PRECAST BASE TYPE	FIXTURE CONFIGURATION (FIX. PER XARM)	FIXTURE AND ACCESSORIES EPA (FT ²)
P4	LSS80D	7B	13 (7+6)	28.6
P8	LSS70E	6B	12 (6+6)	28.8
S5, S6	LSS70C	4B	4 (4)	7.6

DESIGN NOTES

DESIGN PARAMETERS:

WIND: $V_{ult} = 150$ MPH, $V_{asd} = 116$ MPH (EXPOSURE C, RISK CATEGORY II)
PER FBC, 2020 EDITION (ASCE 7-16), SECTION 1609
DESIGN WIND PARAMETERS ARE AS NOTED, ACTUAL EXPOSURE MUST BE VERIFIED FOR THE SITE BY THE PROPER GOVERNING OFFICIAL.

GEOTECHNICAL PARAMETERS:

ALLOWABLE END BEARING SOIL PRESSURE: 2,000 PSF OR SKIN FRICTION: 367 PSF
ALLOWABLE LATERAL SOIL BEARING PRESSURE:
150 PSF/FT (GRADE TO -2'-0"); 300 PSF/FT (BELOW -2'-0")
IN ACCORDANCE WITH THE 2020 EDITION OF THE FLORIDA BUILDING CODE, CHAPTER 18.
SEE TABLE 1806.2, SOIL MATERIAL CLASS 4 & SECTION 1806.3.4.

DESIGN SOIL PARAMETERS ARE AS NOTED. ACTUAL ALLOWABLE SOIL PARAMETERS MUST BE VERIFIED ON SITE.

A GEOTECHNICAL ENGINEER OR REPRESENTATIVE OF IS RECOMMENDED (NOT REQUIRED) TO BE AVAILABLE AT THE TIME OF THE FOUNDATION INSTALLATION TO VERIFY THE SOIL DESIGN PARAMETERS AND TO PROVIDE ASSISTANCE IF ANY PROBLEMS ARISE IN FOUNDATION INSTALLATION.

ENCOUNTERING SOIL FORMATIONS THAT WILL REQUIRE SPECIAL DESIGN CONSIDERATIONS OR EXCAVATION PROCEDURES MAY OCCUR. POLE FOUNDATIONS WILL NEED TO BE ANALYZED ACCORDING TO THE SOIL CONDITIONS THAT EXIST. IF ANY DISCREPANCIES OR INCONSISTENCIES ARISE, NOTIFY THE ENGINEER OF SUCH DISCREPANCIES. FOUNDATIONS WILL THEN BE REVISED ACCORDINGLY. REVISIONS WILL BE ANALYZED PER RECOMMENDATIONS DIRECTED BY A REGISTERED ENGINEER.

ALL EXCAVATIONS MUST BE FREE OF LOOSE SOIL AND DEBRIS PRIOR TO FOUNDATION INSTALLATION AND CONCRETE BACKFILL PLACEMENT. TEMPORARY CASINGS OR DRILLERS SLURRY MAY BE USED TO STABILIZE THE EXCAVATION DURING INSTALLATION. CASINGS MUST BE REMOVED DURING CONCRETE BACKFILL PLACEMENT. CONCRETE BACKFILL MUST BE PLACED WITH A TREMIE WHEN SLURRY OR WATER IS PRESENT WITHIN THE EXCAVATION OR WHEN THE FREE DROP EXCEEDS 6'-0".


CONTRACTOR MUST BE FAMILIAR WITH THE COMPLETE SOIL INVESTIGATION REPORT AND BORINGS, AND CONTACT THE GEOTECHNICAL FIRM (IF NECESSARY) TO UNDERSTAND THE SOIL CONDITIONS AND THE POSSIBILITY OF GROUND WATER PUMPING AND EXCAVATION STABILIZATION OR BRACING DURING PRECAST BASE INSTALLATION AND PLACEMENT OF CONCRETE BACKFILL.

CONCRETE:

CONCRETE SHALL BE AIR-ENTRAINED AND HAVE A MINIMUM COMPRESSIVE DESIGN STRENGTH AT 28 DAYS OF 3,000 PSI. 3,000 PSI CONCRETE SPECIFIED FOR EARLY POLE ERECTION, ACTUAL REQUIRED MINIMUM ALLOWABLE CONCRETE STRENGTH IS 1,000 PSI. ALL PIERS AND CONCRETE BACKFILL MUST BEAR ON AND AGAINST FIRM UNDISTURBED SOIL.

GENERAL NOTES:

FIXTURES MUST BE LOCATED TO MAINTAIN 10'-0" MINIMUM HORIZONTAL CLEARANCE FROM ANY OBSTRUCTION. ENGINEER MUST BE NOTIFIED IF FOUNDATIONS ARE NEAR ANY RETAINING WALLS OR WITHIN / NEAR ANY SLOPES STEEPER THAN 3H : 1V. POLES, FIXTURES, PRECAST BASES, ELECTRICAL ITEMS AND INSTALLATION PER MUSCO LIGHTING.

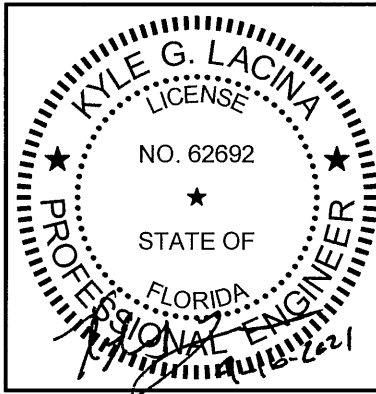

I HEREBY CERTIFY THAT THIS ENGINEERING DOCUMENT WAS PREPARED BY ME OR UNDER MY DIRECT PERSONAL SUPERVISION AND THAT I AM A DULY LICENSED PROFESSIONAL ENGINEER UNDER THE LAWS OF THE STATE OF FLORIDA.

KYLE G. LACINA - NO. PE 62692
LICENSE RENEWAL DATE: FEBRUARY 28, 2022

STRUCTURAL ENGINEERS, P.C. - NO. 26361

DRAWING NO. COVERED BY THIS SEAL: C1

COUNTRYSIDE
ATHLETIC COMPLEX
FIELD LIGHTING - PHASE 3
CLEARWATER, FL



CORPORATE: 100 1st AVE. WEST
OSKALOOSA, IA 52577
(800) 825-6020

STRUCTURAL
ENGINEERS, P.C.
114 NICHOLAS DRIVE
MARSHALLTOWN, IOWA 50158
PHONE NUMBER: 641-752-6334
EMAIL: MSL.INFO@SEPC.BIZ

DRAWING TITLE:
POLE AND FOUNDATION
SCALE: SEE PLAN
NOTES:
SCAN #208806B

PROJECT NUMBER
208806

DATE
16 APRIL 2021

DRAWING NUMBER
C1

OF ONE